

**Comparison of Orangetree Plaza
Comprehensive Sign Plans 2014 and 2015**

	<u>Approved 2014 CSP</u>	<u>Proposed 2015 CSP</u>	<u>Difference</u>
Front Elevation:	Wordmark – 19.53 sq ft	Wordmark – 19.53 sq ft	NA
	-----	Welcome Letters – 2.54 sq ft*	2.54 sq. ft.
Rear Elevation:	Wall Arch – 14 sq ft**	Wall Arch – 14 sq ft	NA
Drive Thru Elevation:	Wordmark/Wall Arch – 60.76 sq ft***	Wordmark/Wall Arch – 60.76 sq ft	NA
	Window Position Signs – 7.5 sq ft	Window Position Signs – 7.5 sq ft	NA
Non Drive Thru Elevation:	Wall Arch – 14 sq ft	Wall Arch – 14 sq ft	NA
	-----	Welcome Letters – 2.54 sq ft*	2.54 sq ft.
Entrance to Drive-Thru	The Drive-Thru and Order Here signs were not listed as signs in 2014 because they weren't thought to be visible. Stipulation Nos. 4 & 5 required that these letters be integrated into Ordering Canopy and Single Arm Gate.	In this amendment, we are requesting that the Drive-Thru and Order Here signs be allowed as requested due to their lack of visibility as demonstrated by the exhibits submitted with the 2015 CSP Amendment application.	


* Stipulation No. 4 required that the 2014 Welcome signs on the entry canopy be relocated to the windows. In this request, they are proposed in the same location as in the 2014 CSP.

** This Wall Arch was not shown on the sign index map (Sheet 301) but the Rear Elevation did include this Wall Arch.

***Pursuant to Stipulation No. 3 of the CSP approval, the Wordmark and Wall Arch signs in 2014 were allowed if the signs were positioned next to each other which is what has been done in this amendment.

Re: Step 2 & 3


FRONT ELEVATION

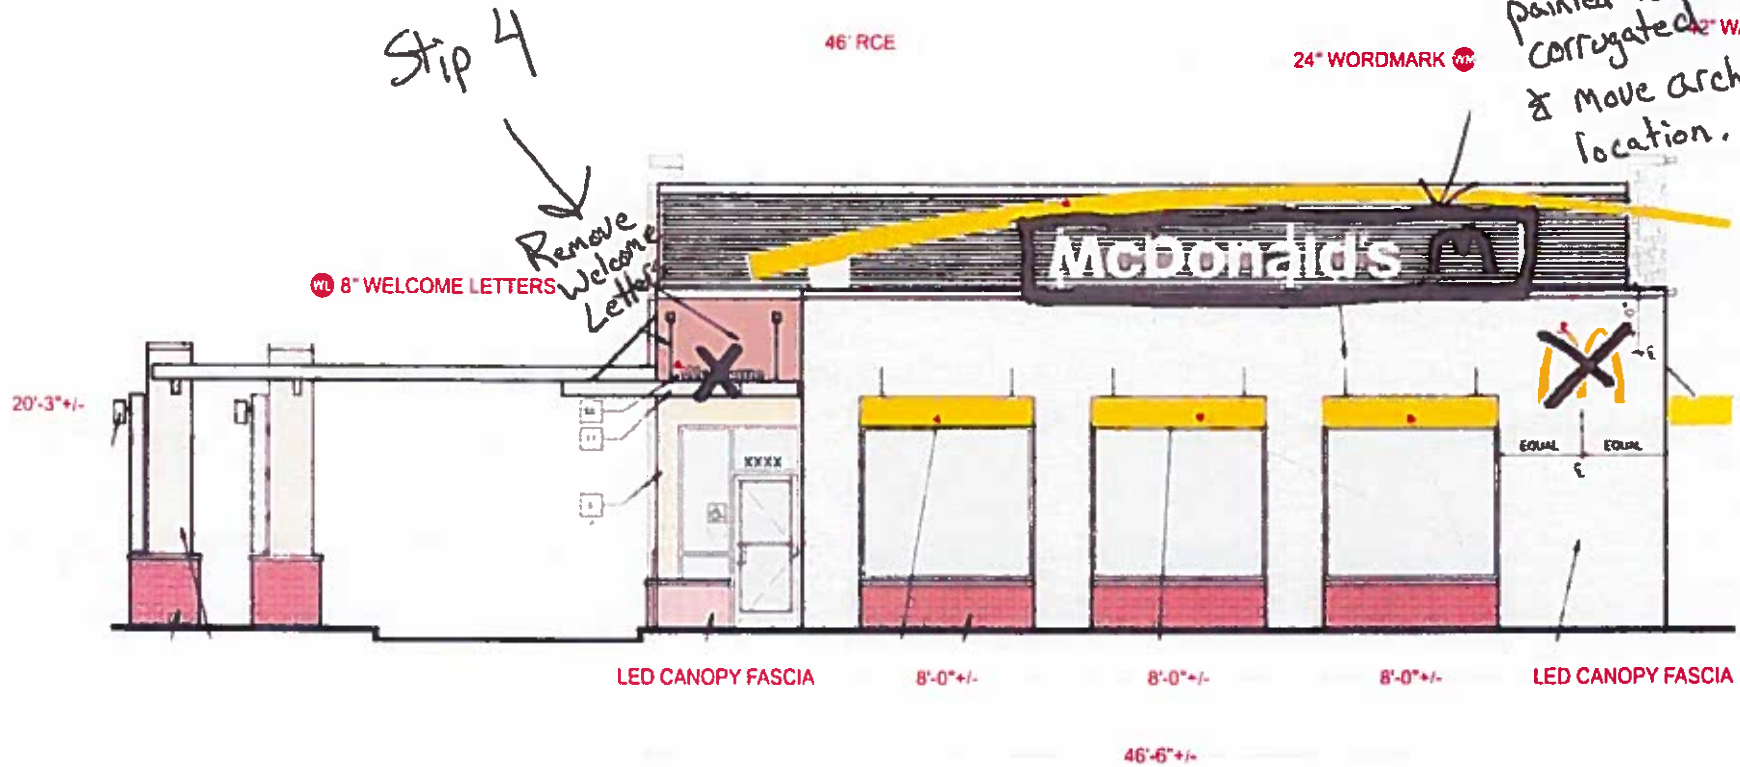

SCALE: 3/16" = 1'-0"

Customer:	McDONALD'S	Date:	04/02/14	Prepared By:	ISU	Eng:	X	Notes: Color sample may vary in actual color. All colors are to be confirmed by the client. All colors are to be confirmed by the client. All colors are to be confirmed by the client.	PERSONA SIGN MAKERS IMAGE BUILDERS DISTRIBUTED BY SIGN UP COMPANY 200 East Street Southwest PO Box 200 Whitehouse, SD 57159-0200 1 (800) 643-7688 • www.persona-inc.com
Location:	MESA, AZ	File Name:	123431 - R5 - 1948 E MCKELLIPS, MESA, AZ - PROGRAM BOOK						

REAR ELEVATION

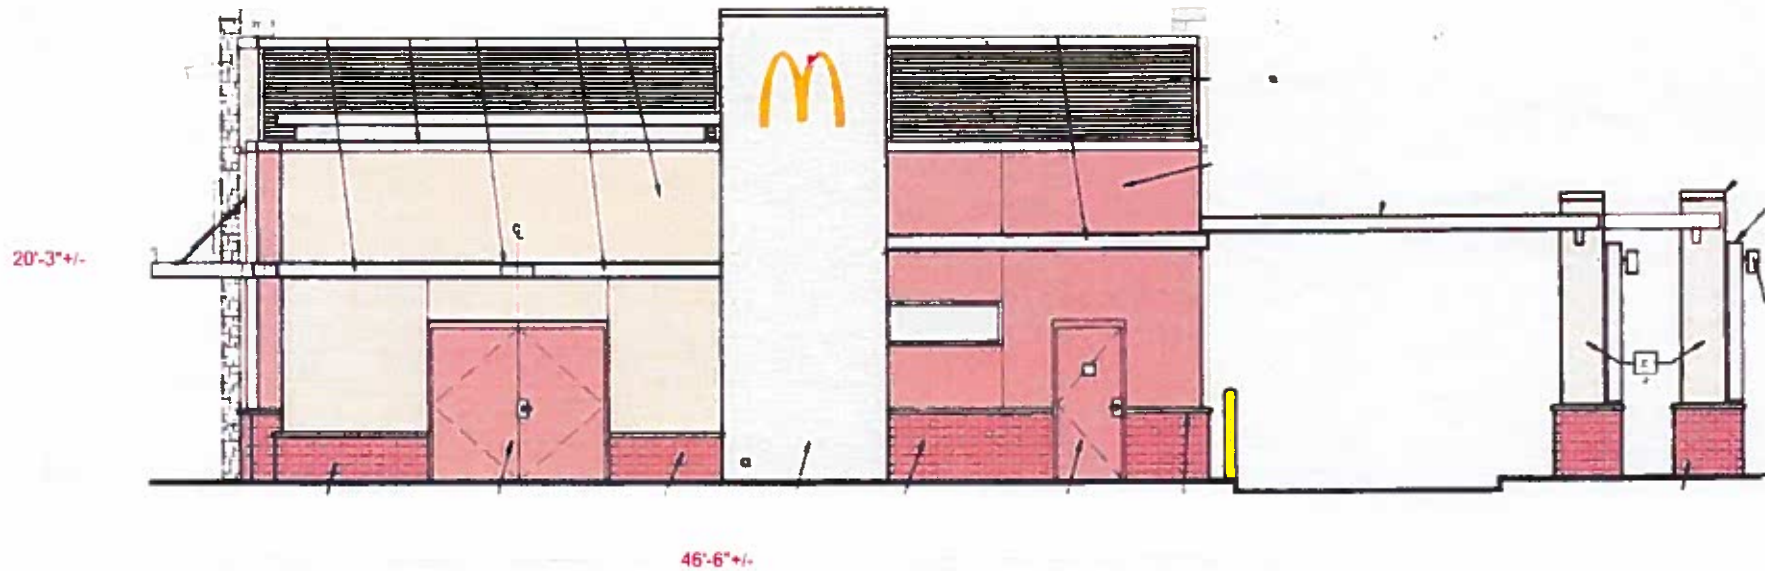42" WALL ARCH 

SCALE: 3/16" = 1'-0"

Customer: McDONALD'S	Date: 04/03/14	Prepared By: ISU	Eng: X	Notes: Color images are not to exceed a max. resolution of 300 dpi. All colors must be CMYK or the closest CMYK equivalent. If there is an overprint, please provide the correct PMS color and a swatch if the drawing will be used.
Location: MESA, AZ	File Name: 123431 - RS - 1948 E MCKELLIPS, MESA, AZ - PROGRAM BOOK			




DISTRIBUTED BY SIGN UP COMPANY
 700 East Street Southwest
 PO Box 300
 Waukegan, IL 60087-0300
 1 (800) 843-7633 • www.persona-inc.com

DRIVE-THRU ELEVATION

Step 3
Relocate
Proposed Signs


24" WORDMARK

42" WALL ARCH

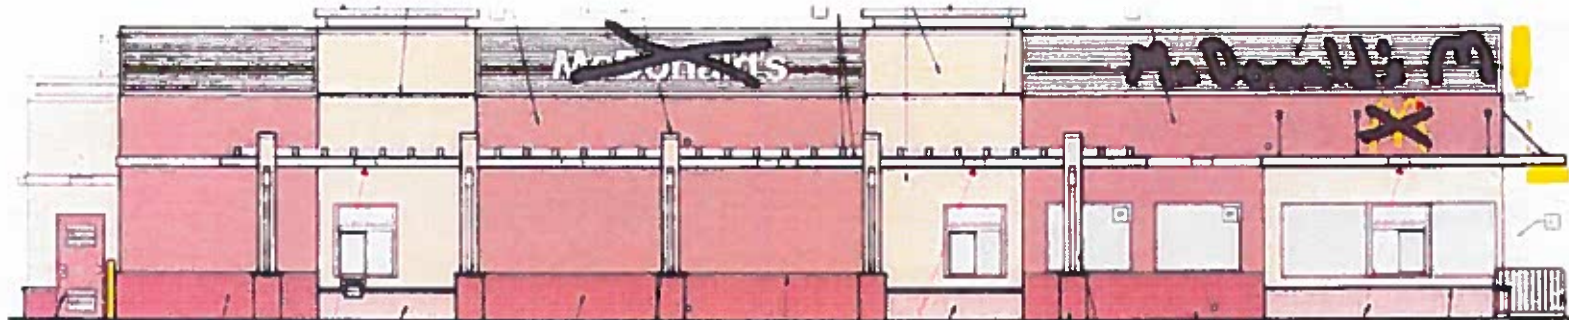

20'-6\"/>

WINDOW POSITION SIGN 1

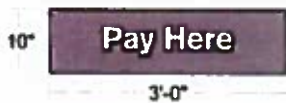

WINDOW POSITION SIGN 2



WINDOW POSITION SIGN 3



104'-3\"/>

SCALE: 1/8\"/>


Customer:	McDONALD'S	Date:	04/02/14	Prepared By:	ISU	Eng:	X	1/8\"/>
Location:	MESA, AZ	File Name:	123431 - R5 - 1948 E MCKELLIPS, MESA, AZ - PROGRAM BOOK					PERSONA SIGN MAKERS IMAGE BUILDERS DISTRIBUTED BY SIGN UP COMPANY 700 West Street Southwest PO Box 200 Waterbury, SD 57080-0200 1 (800) 643-7638 • www.sign-up-inc.com

NON DRIVE-THRU ELEVATION

Step 4
Remove Welcome
Letters

42" WALL ARCH WA

W1 8" WELCOME LETTERS

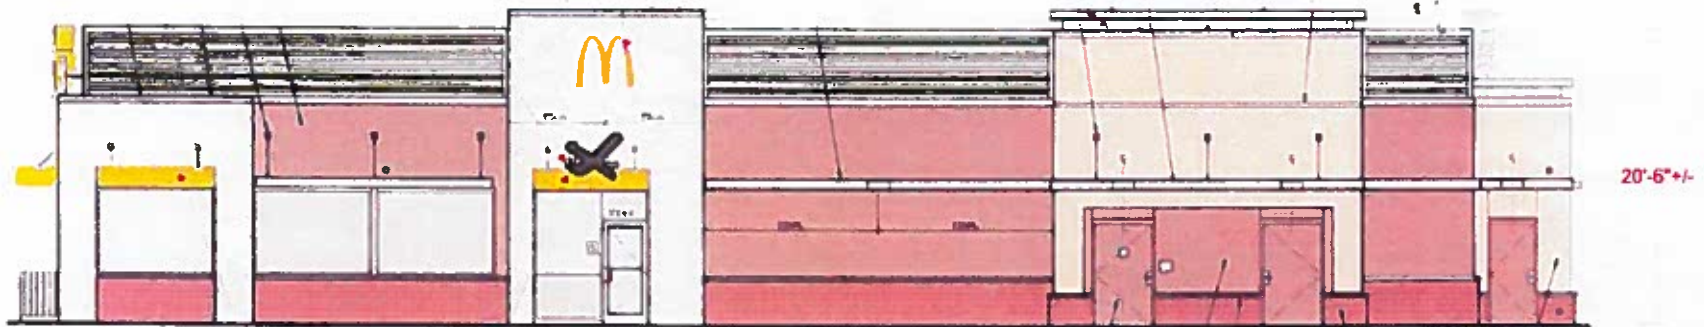

8'-0" +/-

LED CANOPY FASCIA

8'-0" +/-


20'-6" +/-

104'-3" +/-


SCALE: 1/8" = 1'-0"

Customer:	McDONALD'S	Date:	04/02/14	Prepared By:	ISU	Eng:	X	Notes: CA+ expects you get to meet with surveyor or painter for drawing. All notes need to be (P) or the client (V) approved. If there others are involved please provide the correct (P) and a note to the drawing will be made.	 DISTRIBUTED BY SIGN UP COMPANY 700 East Street Southeast PO Box 200 Vidalia, GA 30572-0200 1 (800) 943-7888 • www.persona-inc.com
Location:	MESA, AZ	File Name:	123431 - RS - 1948 E MCKELLIPS, MESA, AZ - PROGRAM BOOK						

Step 5
Remove Drive
Thru Letters

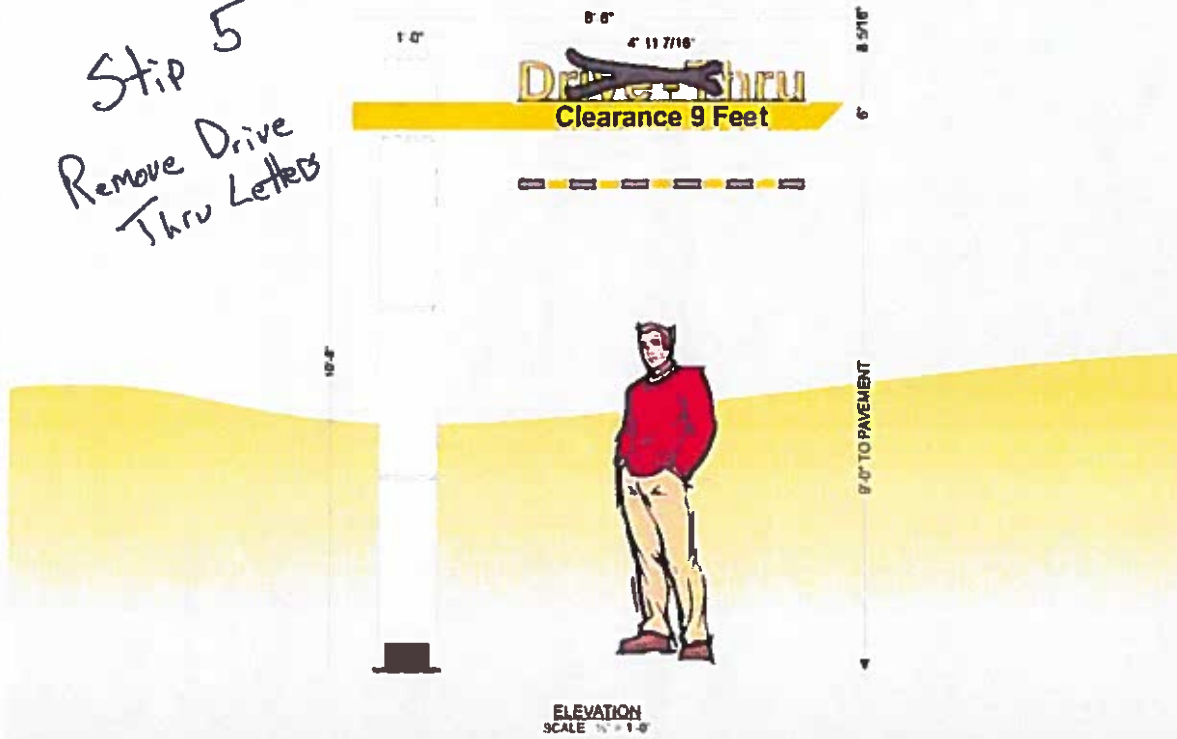

ELEVATION
SCALE 1/4" = 1'-0"

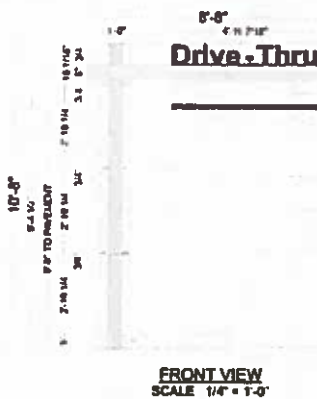

FRONT VIEW
SCALE 1/4" = 1'-0"


- 0807 ALUMINUM CAP
- 3/4" BLACK RIGID PVC BOARD LETTERS
- 18 GAUGE STEEL ARM
- 14 GAUGE CHAIN
- END CAP
- BLACK ABS BAR
- 4MM ACM REVEAL
- 6 X 6 X 3/16" SQUARE TUBE
- 1 X 1 X 1/8" ALUMINUM ANGLE
- 4MM ACM SHROUD
- 0807 ALUMINUM SHROUD
- BASE PLATE

- 0807 ALUMINUM CAP
- 3/4" BLACK RIGID PVC LETTERS
- 18 GAUGE STEEL ARM
- HINGE
- 14 GAUGE CHAIN
- BLACK ABS BAR
- 4MM ACM REVEAL
- 6 X 6 X 3/16" SQUARE TUBE
- 1 X 1 X 1/8" ALUMINUM ANGLE
- 4MM ACM SHROUD
- 0807 ALUMINUM SHROUD
- BASE PLATE

END VIEW
SCALE 1/4" = 1'-0"



GRAPHIC DETAIL
SCALE 1/4" = 1'-0"

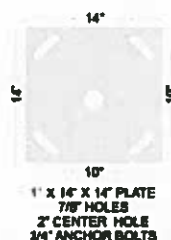

BASE PLATE DETAIL
SCALE: 1" = 1'-0"

POLE COVER DETAIL

DESIGN FACTOR: TBD
4MM WHITE ACM POLE COVER
0807 ALUMINUM CAP AND SHROUD
EXTERIOR FINISH:
POLE COVER & REVEALS -
PRE-FINISHED BONE WHITE
SHROUD AND BASE PLATE - MATCH
B M 2130-20 DEEP CAVIAR

CLEARANCE BAR DETAIL

BLACK ACM PIPE W/ 7725-15 YELLOW
VINYL STRIPES APPLIED TO 1ST
SURFACE

SQUARE FEET: BOXED = 82.44
ACTUAL = 15.68

SWING ARM DETAIL


DESIGN FACTOR: TBD
18 GAUGE STEEL ARM WITH HINGE
W/ 1ST SURFACE PAINT AND VINYL
DECORATION.

MATCH PMS 108 C YELLOW - SWING ARM
7725-12 BLACK VINYL - "CLEARANCE 9 FEET"
COPY

"DRIVE-THRU" LETTER DETAIL



3/4" BLACK RIGID PVC BOARD ROUTED
LETTERS W/ 1ST SURFACE VINYL
DECORATION

7725-15 BRIGHT YELLOW - "DRIVE-
THRU" COPY
BLACK - COPY OUTLINE

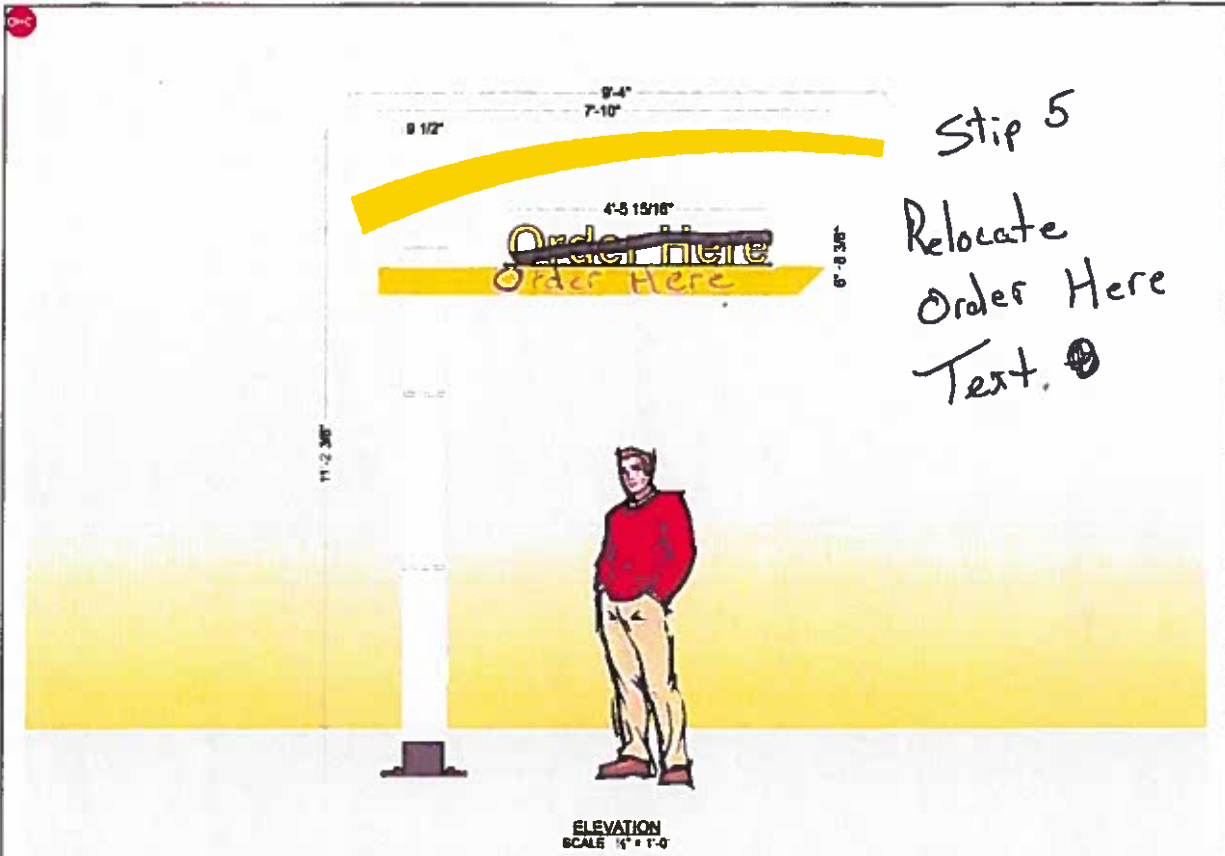

- MOLDED FIBERGLASS CANOPY TOP
- 1 1/4" X 1 1/4" X 1/4" SQUARE TUBE
- STEEL RIBS
- ALUMINUM LIGHT BOX FRAME
- 4-LAMP BALLAST
- 3/4" BLACK RIGID PVC BOARD LETTERS
- 6 X 6 X 1/8 GAUGE STEEL SWING ARM
- ATTACHMENT PLATES (SEE DETAIL)
- SPACING BRACKET
- 4MM ACM SIGN
- (2) 2 X 6 X 3/16" RECTANGULAR TUBES
- BASE PLATE (SEE DETAIL)

- MOLDED FIBERGLASS CANOPY TOP
- 1 1/4" X 1 1/4" X 1/4" SQUARE TUBE
- (4) 40" T12 FLUORESCENT LAMPS
- 3/4" BLACK RIGID PVC BOARD LETTERS
- 6" X 6" X 1/8 GAUGE STEEL SWING ARM
- HINGE
- 1 X 1 X 1/8" ALUMINUM ANGLE
- 2 X 6 X 3/16" ANGLE IRON
- SPEAKER/MICROPHONE BY OTHERS
- SPACING BRACKET
- SCREEN BY OTHERS
- 4MM ACM SIGN
- SPEAKER/MICROPHONE BY OTHERS
- (2) 2 X 6 X 3/16" RECTANGULAR TUBES
- 6 X 6 X 3/16" RECTANGULAR TUBE
- BASE PLATE (SEE DETAIL)

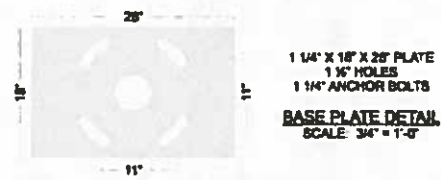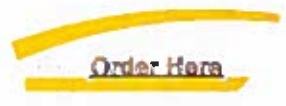

SQUARE FOOTAGE: ACTUAL = 17.10
BOXED = 104.51

FIBERGLASS CANOPY DETAIL
DESIGN FACTOR: T80
FIBERGLASS CANOPY WITH STEEL TUBE AND RIB INTERNAL STRUCTURE
EXTERIOR FINISH: PAINT TO MATCH PMS 109 C YELLOW
LIGHT LENS REMOVABLE FOR SERVICE
U.L. APPROVED
ELECTRICAL: 1.90 AMPS, 120 VOLTS

BASE DETAIL
DESIGN FACTOR: 90 MPH
ALUMINUM ANGLE IRON STRUCTURE
4MM ACM SKIN
EXTERIOR FINISH:
SWING ARM - PAINT TO MATCH PMS 109 C YELLOW
BASE - BONE WHITE
SHROUD & POLE - DEEP CAVAR
U.L. APPROVED

"ORDER HERE" LETTER DETAIL
3/4" BLACK RIGID PVC BOARD LETTERS W/ 1ST SURFACE VINYL DECORATION:
7725-15 BRIGHT YELLOW - "ORDER HERE" COPY
BLACK - COPY OUTLINE