

GENERAL NOTES	LEGEND	KEYED NOTES	KEYED NOTES	NOTES
1. PROVIDE TCA GRADE 'A' PATCHING AT OFFICE AREA. ALL OTHER AREAS TO BE TCA GRADE 'B' PATCHING	XPT-1 - SHERWIN WILLIAMS COLOR, CLAYCO FLAGSTONE (518-4)	A "V" TYPE REVEAL IN CONC. TILT-UP PANEL	1 CONCRETE TILT-UP PANEL, PAINTED	17 TEXTURED CONCRETE FORMLINER CORNICE
2. ALL DIMENSIONS ARE TO FACE OF CONCRETE OR ROUGH OPENING. SEE FLOOR PLANS, SECTIONS, AND ELEVATIONS	XPT-2 - SHERWIN WILLIAMS COLOR, CLAYCO DOVER GRAY (518-5)		2 CONCRETE DRIVE-IN RAMP WITH CONCRETE RETAINING WALL AND GALV. STL. PIPE GUARDRAIL	18 TEXTURED CONCRETE FORMLINER RECESS
3. ALL EXPOSED SIDES OF CONCRETE TILT-UP PANEL TO BE PAINTED.	XPT-3 - SHERWIN WILLIAMS COLOR, CLAYCO KNIGHTS ARMOR (518-6)		3 14' - 0" W x 16' - 0" H DRIVE-IN DOOR, PREFINISHED TO MATCH ADJACENT WALL COLOR. SEE OH DOOR SCHEDULE	19 OVERFLOW SCUPPER
4. CONCRETE FILLED BOLLARDS TO BE PAINTED "SAFETY YELLOW".	XPT-4 - SHERWIN WILLIAMS COLOR, CLAYCO RED		4 HOLLOW METAL DOOR AND FRAME, PAINTED TO MATCH ADJACENT WALL COLOR. SEE DOOR SCHEDULE	20 CONCRETE LAP PANEL
5. ALL EXTERIOR HOLLOW METAL DOORS, FRAMES AND OVERHEAD DOORS TO BE PAINTED TO MATCH ADJACENT WALL COLOR.	CMP-1 - COMPOSITE METAL PANEL, REYNOBOND - COLORWELD 500 SILVERSMITH		5 GALVANIZED STEEL DOCK STAIR	
6. ALL TILT-UP DIMENSIONS TAKEN FROM CENTER OF REVEAL.	CMU-1 - ARCHITECTURAL CMU, ATHENIA SPLIT FACE, MIDWEST BLOCK & BRICK, COLOR - EBONY		6 GRAY TINTED WINDOWS IN BLACK ALUMINUM STOREFRONT	
7. PROVIDE REVEAL AT TRANSITION OF PAINT COLOR (HORIZONTAL & VERTICAL).			7 9' - 0" W x 10' - 0" H OH DOCK DOOR, PREFINISHED TO MATCH ADJACENT WALL COLOR. SEE OH DOOR SCHEDULE	
8. SEE SHEET A3.501 FOR EXTERIOR CONCRETE PANEL JOINTS, U.N.O.			8 4' X 4' CLERESTORY WINDOW	
9. EXTERIOR SECTIONAL DOORS TO MATCH ADJACENT WALL COLOR. CUSTOM FACTORY FINISH.				
10. DO NOT PROVIDE A REVEAL AT THE KNOCK OUT PANELS.				
11. THE EXTERIOR FACING SURFACES OF THE TILT-UP PANELS BEHIND THE ALUMINUM WINDOW AND COMPOSITE METAL PANEL SYSTEMS MUST BE FULLY PAINTED PRIOR TO INSTALLATION OF THE SYSTEMS. UNPAINTED SURFACES MUST BE SUPPLEMENTED WITH AN APPLIED AIR AND MOISTURE BARRIER				



DRAWING ISSUE


DESCRIPTION	DATE
DESIGN REVIEW	03.21.2022
1ST REVIEW COMMENTS	04.22.2022

DRAWING TITLE
BUILDING ELEVATIONS - NORTH

DRAWING NO.

A3.201


Job #	006329
-------	--------

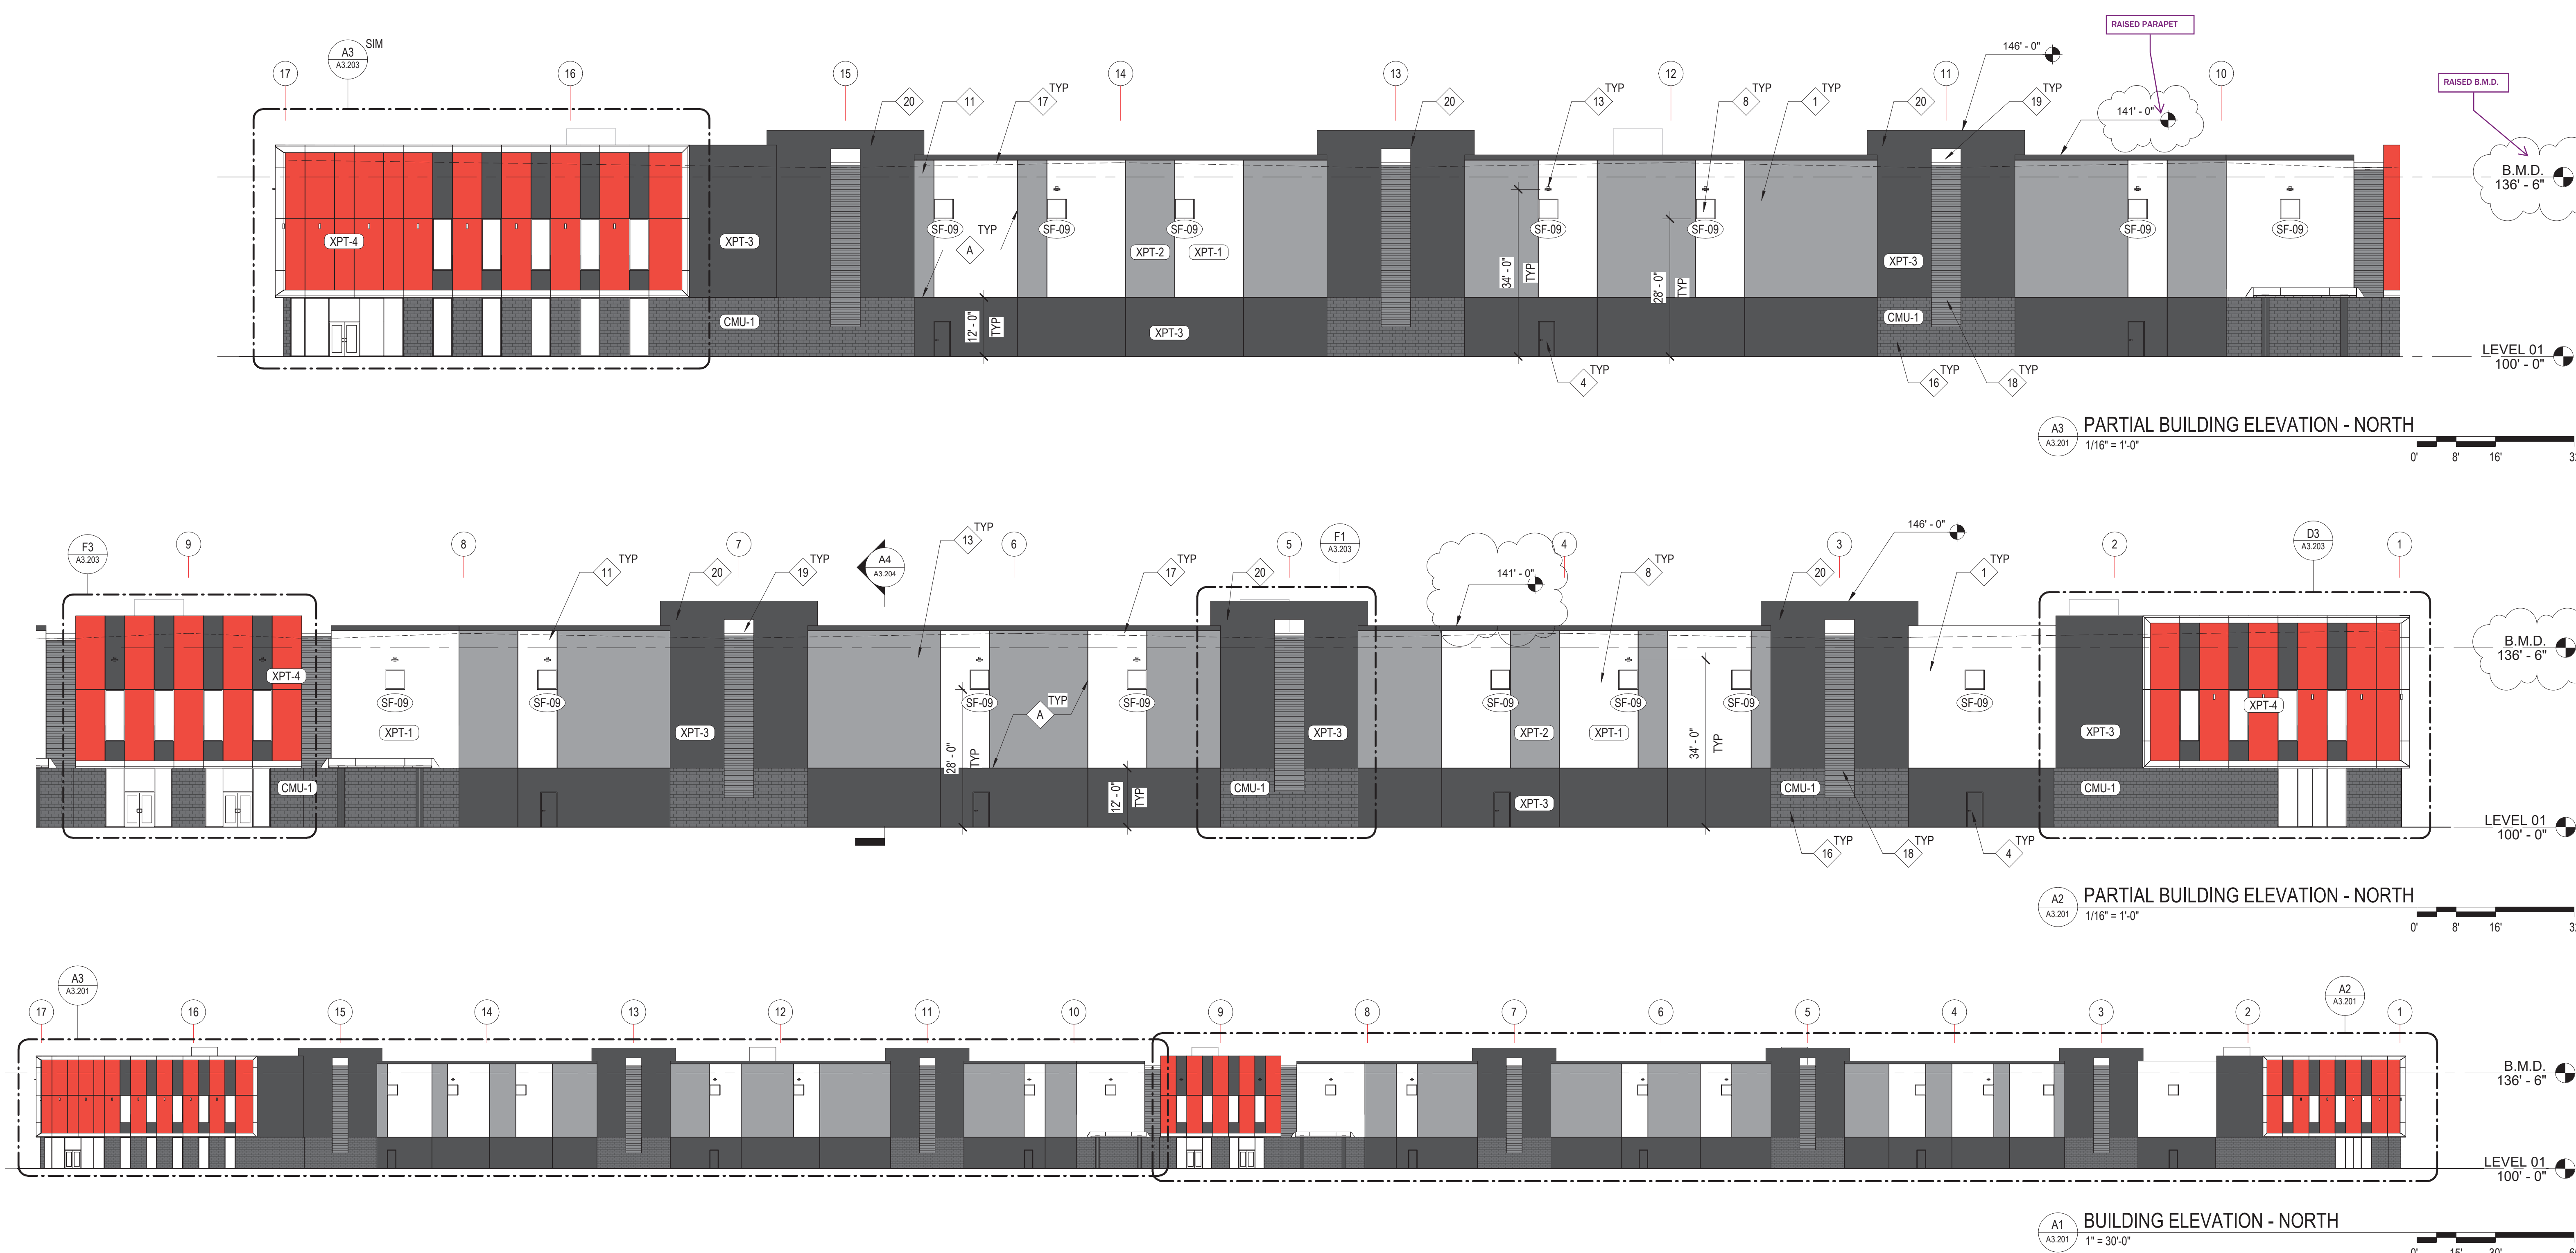

EXTERIOR ELEVATION NOTES

GENERAL NOTES	LEGEND	KEYED NOTES	KEYED NOTES	NOTES
1. PROVIDE TCA GRADE "A" PATCHING AT OFFICE AREA. ALL OTHER AREAS TO BE TCA GRADE "B" PATCHING.	XPT-1 - SHERWIN WILLIAMS COLOR, CLAYCO FLAGSTONE (518-4)	A "Y" TYPE REVEAL IN CONC. TILT-UP PANEL	1 CONCRETE TILT-UP PANEL, PAINTED	BUILDING B ELEVATIONS ARE THE SAME AS BUILDING A BUT OPPOSITE. REFER TO SHEETS AA2.101 & AB2.101 FOR ELEVATION REFERENCES.
2. ALL DIMENSIONS ARE TO FACE OF CONCRETE OR ROUGH OPENING. SEE FLOOR PLANS, SECTIONS, AND ELEVATIONS	XPT-2 - SHERWIN WILLIAMS COLOR, CLAYCO DOVER GRAY (518-5)		2 CONCRETE DRIVE-IN RAMP WITH CONCRETE RETAINING WALL AND GALV. STL. PIPE GUARDRAIL	
3. ALL EXPOSED SIDES OF CONCRETE TILT-UP PANEL TO BE PAINTED.	XPT-3 - SHERWIN WILLIAMS COLOR, CLAYCO KNIGHTS ARMOR (518-6)		3 14'-0" W x 16'-0" H OH DRIVE-IN DOOR, PREFINISHED TO MATCH ADJACENT WALL COLOR. SEE OH DOOR SCHEDULE	
4. CONCRETE FILLED BOLLARDS TO BE PAINTED "SAFETY YELLOW"	XPT-4 - SHERWIN WILLIAMS COLOR, CLAYCO RED		4 HOLLOW METAL DOOR AND FRAME, PAINTED TO MATCH ADJACENT WALL COLOR. SEE DOOR SCHEDULE	
5. ALL EXTERIOR HOLLOW METAL DOORS, FRAMES AND OVERHEAD DOORS TO BE PAINTED TO MATCH ADJACENT WALL COLOR.	CMP-1 - COMPOSITE METAL PANEL, REYNOBOND - COLORWELD 500 SILVERSMITH		5 GALVANIZED STEEL DOCK STAIR	
6. ALL TILT-UP DIMENSIONS TAKEN FROM CENTER OF REVEAL.	CMTU-1 - ARCHITECTURAL CMU, ATHENA SPLIT FACE, MIDWEST BLOCK & BRICK, COLOR - EBONY		6 GRAY TINTED WINDOWS IN BLACK ALUMINUM STOREFRONT	
7. PROVIDE REVEAL AT TRANSITION OF PAINT COLOR (HORIZONTAL & VERTICAL).			7 9'-0" W x 10'-0" H OH DOCK DOOR, PREFINISHED TO MATCH ADJACENT WALL COLOR. SEE OH DOOR SCHEDULE	
8. SEE SHEET A3.501 FOR EXTERIOR CONCRETE PANEL JOINTS, U.N.O.			8 4' X 4' CLERESTORY WINDOW	
9. EXTERIOR SECTIONAL DOORS TO MATCH ADJACENT WALL COLOR. CUSTOM FACTORY FINISH.				
10. DO NOT PROVIDE A REVEAL AT THE KNOCK OUT PANELS.				
11. THE EXTERIOR FACING SURFACES OF THE TILT-UP PANELS BEHIND THE ALUMINUM WINDOW AND COMPOSITE METAL PANEL SYSTEMS MUST BE FULLY PAINTED PRIOR TO INSTALLATION OF THE SYSTEMS. UNPAINTED SURFACES MUST BE SUPPLEMENTED WITH AN APPLIED AIR AND MOISTURE BARRIER				

ADDED LEGEND

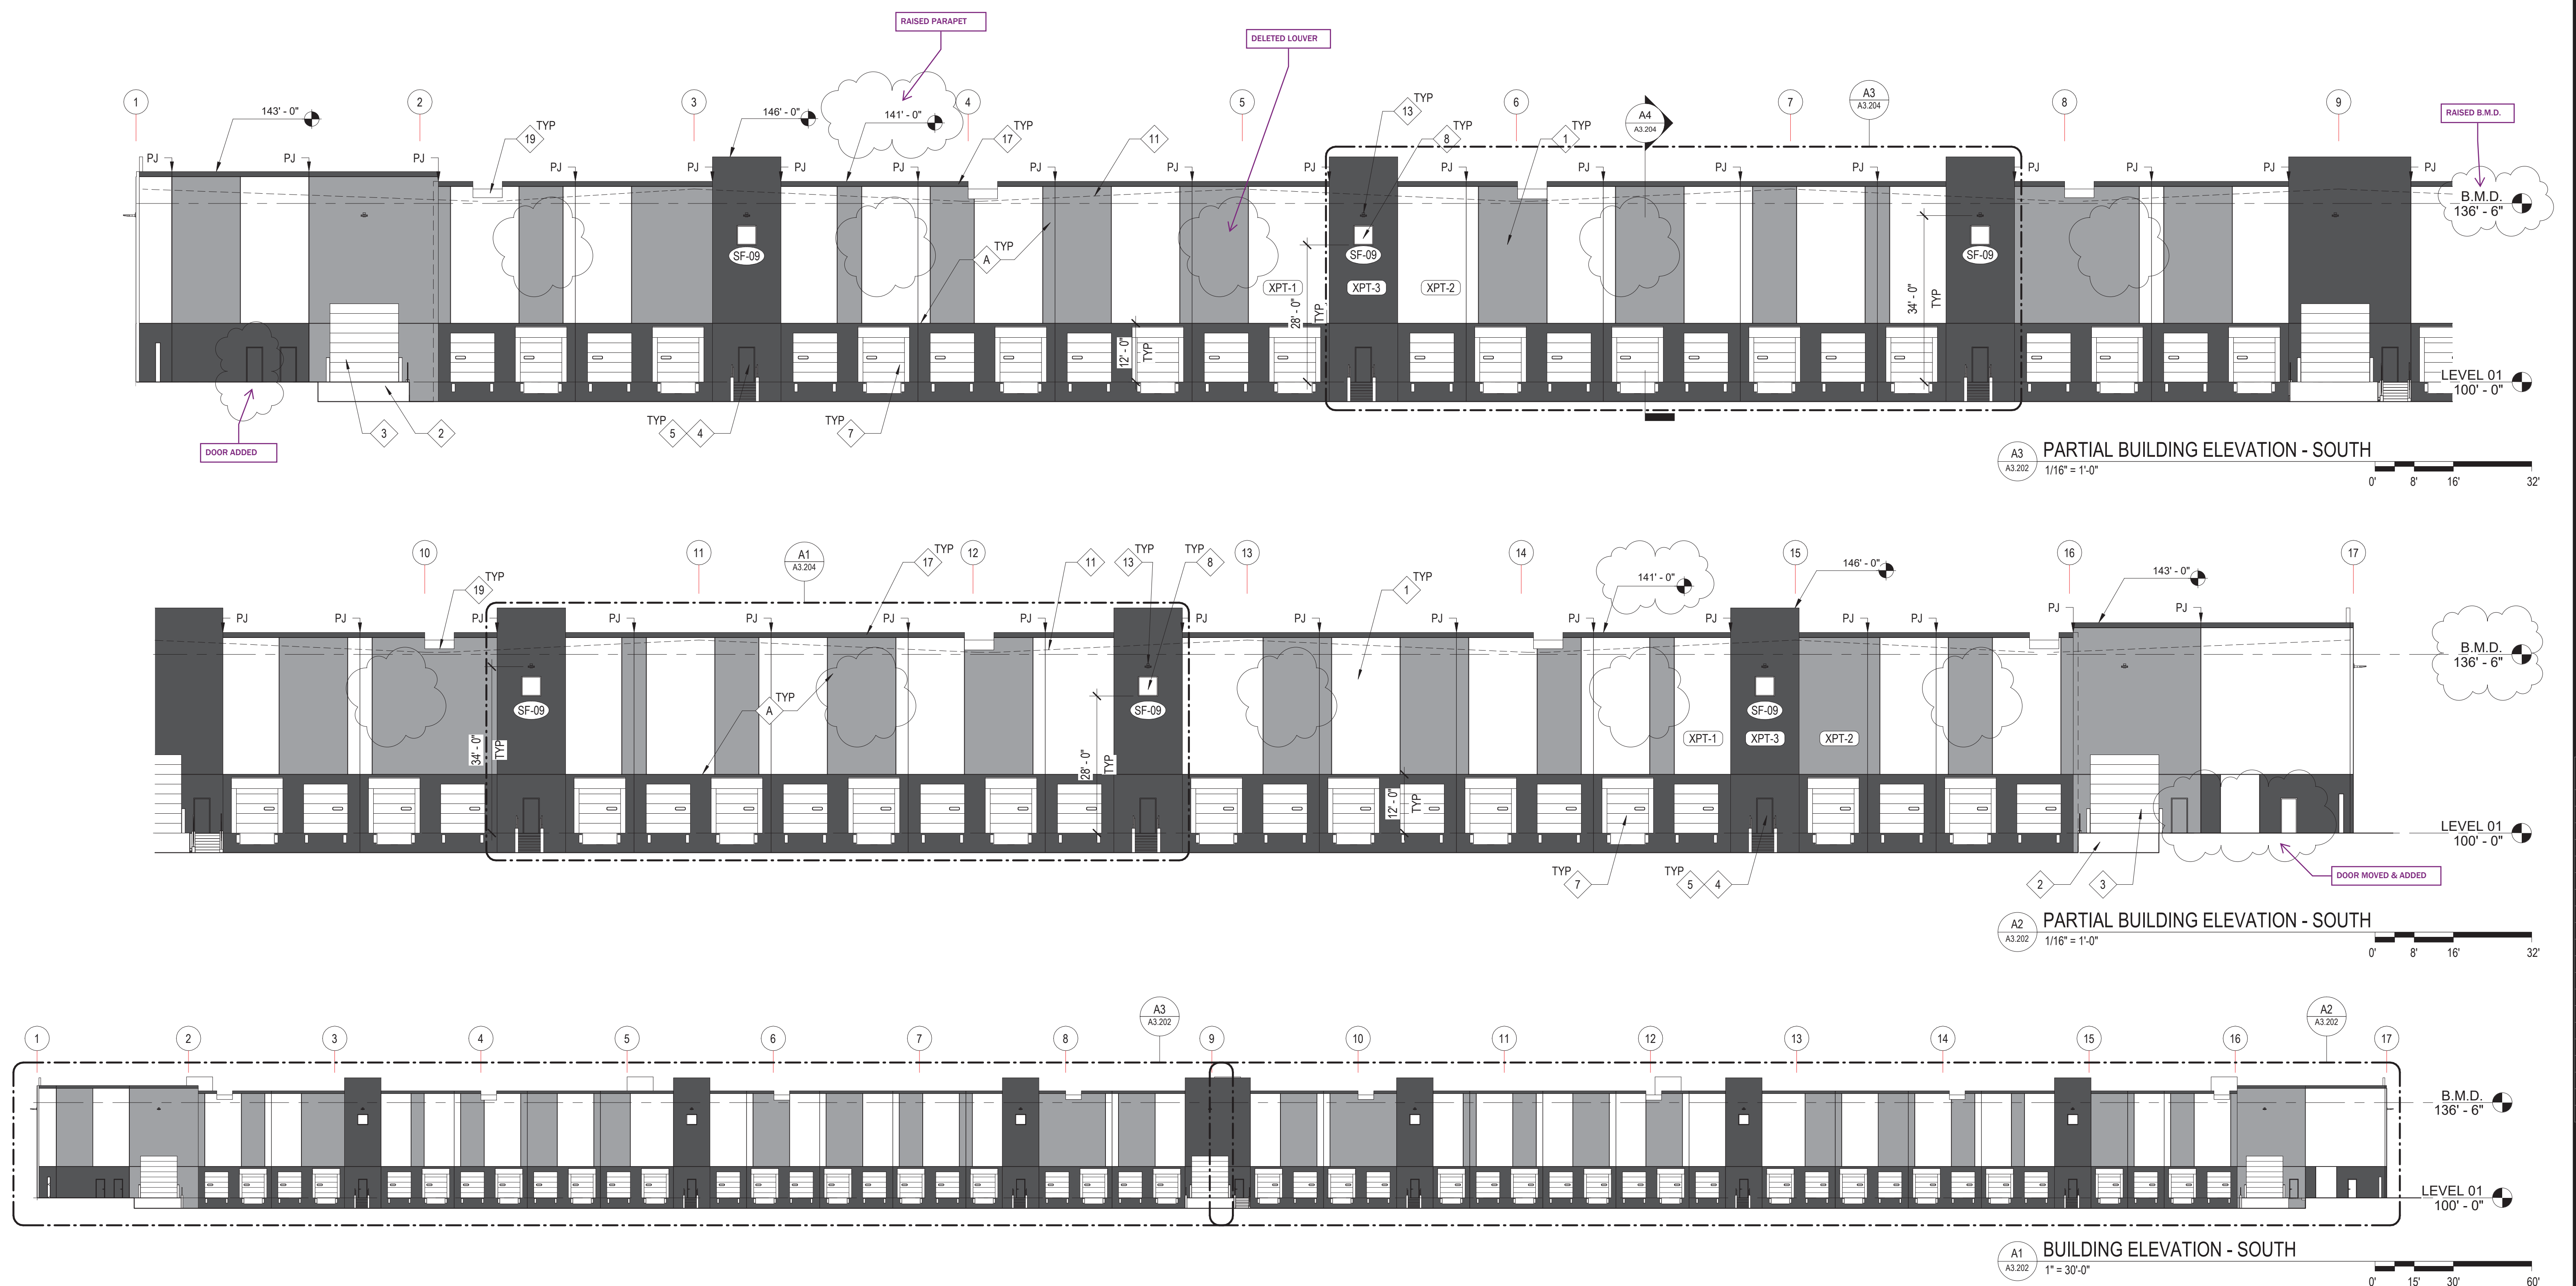

CLAYCO
THE ART & SCIENCE OF BUILDING
2199 INNERBELT BUSINESS CENTER DRIVE
ST. LOUIS, MISSOURI 63114
PH 314.429.5100 FX 314.429.3137

Amar Johnson
collaborative

2199 INNERBELT BUSINESS CENTER DR
ST. LOUIS, MISSOURI 63114
Ph 314/429-1111



04.22.2022

INTEGRATED
REAL ESTATE
SOLUTIONS

THE CUBES AT MESA - BLDG A
E PECOS RD & S CRISMON RD, MESA, AZ 85212

DRAWING ISSUE

DESCRIPTION	DATE
IN REVIEW	03.21.20
REVIEW COMMENTS	04.22.20

WING TITLE
DING ELEVATIONS - SOUTH


WING NO.

A3.202


006329

EXTERIOR ELEVATION NOTES


GENERAL NOTES	LEGEND	KEYED NOTES	KEYED NOTES	NOTES																																																																														
1. PROVIDE TCA GRADE 'A' PATCHING AT OFFICE AREA. ALL OTHER AREAS TO BE TCA GRADE 'B' PATCHING.	XPT-1 - SHERWIN WILLIAMS COLOR, CLAYCO FLAGSTONE (518-4)	A "V" TYPE REVEAL IN CONC. TILT-UP PANEL	1 CONCRETE TILT-UP PANEL, PAINTED	BUILDING B ELEVATIONS ARE THE SAME AS BUILDING A BUT OPPOSITE. REFER TO SHEETS A42.101 & A82.101 FOR ELEVATION REFERENCES.																																																																														
2. ALL DIMENSIONS ARE TO FACE OF CONCRETE OR ROUGH OPENING. SEE FLOOR PLANS, SECTIONS, AND ELEVATIONS	XPT-2 - SHERWIN WILLIAMS COLOR, CLAYCO DOVER GRAY (518-5)		2 CONCRETE DRIVE-IN RAMP WITH CONCRETE RETAINING WALL AND GALV. STL. PIPE GUARDRAIL																																																																															
3. ALL EXPOSED SIDES OF CONCRETE TILT-UP PANEL TO BE PAINTED.	XPT-3 - SHERWIN WILLIAMS COLOR, CLAYCO KNIGHTS ARMOR (518-6)		3 14' - 0" W x 16' - 0" H OH DRIVE-IN DOOR, PREFINISHED TO MATCH ADJACENT WALL COLOR. SEE OH DOOR SCHEDULE																																																																															
4. CONCRETE FILLED BOLLARDS TO BE PAINTED "SAFETY YELLOW"	XPT-4 - SHERWIN WILLIAMS COLOR, CLAYCO RED		4 HOLLOW METAL DOOR AND FRAME, PAINTED TO MATCH ADJACENT WALL COLOR. SEE DOOR SCHEDULE																																																																															
5. ALL EXTERIOR HOLLOW METAL DOORS, FRAMES AND OVERHEAD DOORS TO BE PAINTED TO MATCH ADJACENT WALL COLOR.	CMP-1 - COMPOSITE METAL PANEL, REYNOBOND - COLORWELD 500 SILVERSMITH		5 GALVANIZED STEEL DOCK STAIR	<table><tr><th colspan="3">BUILDING MATERIAL PERCENTAGES</th><th colspan="3">(BUILDING ELEVATIONS)</th></tr><tr><td>NORTH:</td><td>38,548 SF</td><td>100 %</td><td>EAST:</td><td>13,038 SF</td><td>100 %</td></tr><tr><td>CONCRETE:</td><td>30,837 SF</td><td>79 %</td><td>CONCRETE:</td><td>11,035 SF</td><td>85 %</td></tr><tr><td>TEXTURED CONCRETE:</td><td>1,492 SF</td><td>4 %</td><td>TEXTURED CONCRETE:</td><td>400 SF</td><td>3 %</td></tr><tr><td>SPLIT-FACED CMU VENEER:</td><td>4,297 SF</td><td>11 %</td><td>SPLIT-FACED CMU VENEER:</td><td>1,078 SF</td><td>8 %</td></tr><tr><td>ALUMINUM & GLASS:</td><td>1,788 SF</td><td>5 %</td><td>ALUMINUM & GLASS:</td><td>450 SF</td><td>3 %</td></tr><tr><td>DOORS:</td><td>144 SF</td><td>1 %</td><td>DOORS:</td><td>75 SF</td><td>1 %</td></tr><tr><td>SOUTH:</td><td>40,674 SF</td><td>100 %</td><td>WEST:</td><td>13,038 SF</td><td>100 %</td></tr><tr><td>CONCRETE:</td><td>34,623 SF</td><td>85 %</td><td>CONCRETE:</td><td>10,763 SF</td><td>84 %</td></tr><tr><td>TEXTURED CONCRETE:</td><td>0 SF</td><td>0 %</td><td>TEXTURED CONCRETE:</td><td>382 SF</td><td>2 %</td></tr><tr><td>SPLIT-FACED CMU VENEER:</td><td>0 SF</td><td>0 %</td><td>SPLIT-FACED CMU VENEER:</td><td>1,003 SF</td><td>7 %</td></tr><tr><td>ALUMINUM & GLASS:</td><td>96 SF</td><td>1 %</td><td>ALUMINUM & GLASS:</td><td>840 SF</td><td>6 %</td></tr><tr><td>DOORS:</td><td>5,955 SF</td><td>14 %</td><td>DOORS:</td><td>50 SF</td><td>1 %</td></tr></table>	BUILDING MATERIAL PERCENTAGES			(BUILDING ELEVATIONS)			NORTH:	38,548 SF	100 %	EAST:	13,038 SF	100 %	CONCRETE:	30,837 SF	79 %	CONCRETE:	11,035 SF	85 %	TEXTURED CONCRETE:	1,492 SF	4 %	TEXTURED CONCRETE:	400 SF	3 %	SPLIT-FACED CMU VENEER:	4,297 SF	11 %	SPLIT-FACED CMU VENEER:	1,078 SF	8 %	ALUMINUM & GLASS:	1,788 SF	5 %	ALUMINUM & GLASS:	450 SF	3 %	DOORS:	144 SF	1 %	DOORS:	75 SF	1 %	SOUTH:	40,674 SF	100 %	WEST:	13,038 SF	100 %	CONCRETE:	34,623 SF	85 %	CONCRETE:	10,763 SF	84 %	TEXTURED CONCRETE:	0 SF	0 %	TEXTURED CONCRETE:	382 SF	2 %	SPLIT-FACED CMU VENEER:	0 SF	0 %	SPLIT-FACED CMU VENEER:	1,003 SF	7 %	ALUMINUM & GLASS:	96 SF	1 %	ALUMINUM & GLASS:	840 SF	6 %	DOORS:	5,955 SF	14 %	DOORS:	50 SF	1 %
BUILDING MATERIAL PERCENTAGES			(BUILDING ELEVATIONS)																																																																															
NORTH:	38,548 SF	100 %	EAST:		13,038 SF	100 %																																																																												
CONCRETE:	30,837 SF	79 %	CONCRETE:		11,035 SF	85 %																																																																												
TEXTURED CONCRETE:	1,492 SF	4 %	TEXTURED CONCRETE:	400 SF	3 %																																																																													
SPLIT-FACED CMU VENEER:	4,297 SF	11 %	SPLIT-FACED CMU VENEER:	1,078 SF	8 %																																																																													
ALUMINUM & GLASS:	1,788 SF	5 %	ALUMINUM & GLASS:	450 SF	3 %																																																																													
DOORS:	144 SF	1 %	DOORS:	75 SF	1 %																																																																													
SOUTH:	40,674 SF	100 %	WEST:	13,038 SF	100 %																																																																													
CONCRETE:	34,623 SF	85 %	CONCRETE:	10,763 SF	84 %																																																																													
TEXTURED CONCRETE:	0 SF	0 %	TEXTURED CONCRETE:	382 SF	2 %																																																																													
SPLIT-FACED CMU VENEER:	0 SF	0 %	SPLIT-FACED CMU VENEER:	1,003 SF	7 %																																																																													
ALUMINUM & GLASS:	96 SF	1 %	ALUMINUM & GLASS:	840 SF	6 %																																																																													
DOORS:	5,955 SF	14 %	DOORS:	50 SF	1 %																																																																													
6. ALL TILT-UP DIMENSIONS TAKEN FROM CENTER OF REVEAL.	CMU-1 - ARCHITECTURAL CMU, ATHENIA SPLIT FACE, MIDWEST BLOCK & BRICK, COLOR - EBONY		6 GRAY TINTED WINDOWS IN BLACK ALUMINUM STOREFRONT																																																																															
7. PROVIDE REVEAL AT TRANSITION OF PAINT COLOR (HORIZONTAL & VERTICAL).			7 9' - 0" W x 10' - 0" H OH DOCK DOOR, PREFINISHED TO MATCH ADJACENT WALL COLOR. SEE OH DOOR SCHEDULE																																																																															
8. SEE SHEET A3.501 FOR EXTERIOR CONCRETE PANEL JOINTS, U.N.O.			8 4' X 4' CLERESTORY WINDOW																																																																															
9. EXTERIOR SECTIONAL DOORS TO MATCH ADJACENT WALL COLOR. CUSTOM FACTORY FINISH.			9 BIKE RACK																																																																															
10. DO NOT PROVIDE A REVEAL AT THE KNOCK OUT PANELS.			10 NOT USED																																																																															
11. THE EXTERIOR FACING SURFACES OF THE TILT-UP PANELS BEHIND THE ALUMINUM WINDOW AND COMPOSITE METAL PANEL SYSTEMS MUST BE FULLY PAINTED PRIOR TO INSTALLATION OF THE SYSTEMS. UNPAINTED SURFACES MUST BE SUPPLEMENTED WITH AN APPLIED AIR AND MOISTURE BARRIER			11 ROOF LINE BEYOND																																																																															
			12 EXTERIOR EGRESS LIGHTING FIXTURE, CENTER ABOVE DOOR. SEE ELECTRICAL																																																																															
			13 WALL PACK LIGHTING FIXTURE, SEE ELECTRICAL																																																																															
			14 COMPOSITE METAL PANEL ON METAL STUD FRAMING WITH MITERED CORNERS																																																																															
			15 COMPOSITE METAL PANEL JOINT, SEE DTL. E1/A3.605																																																																															
			16 SPLIT-FACED CMU VENEER																																																																															
			17 TEXTURED CONCRETE FORMLINER CORNICE																																																																															
			18 TEXTURED CONCRETE FORMLINER RECESS																																																																															
			19 OVERFLOW SCUPPER																																																																															
			20 CONCRETE LAP PANEL																																																																															

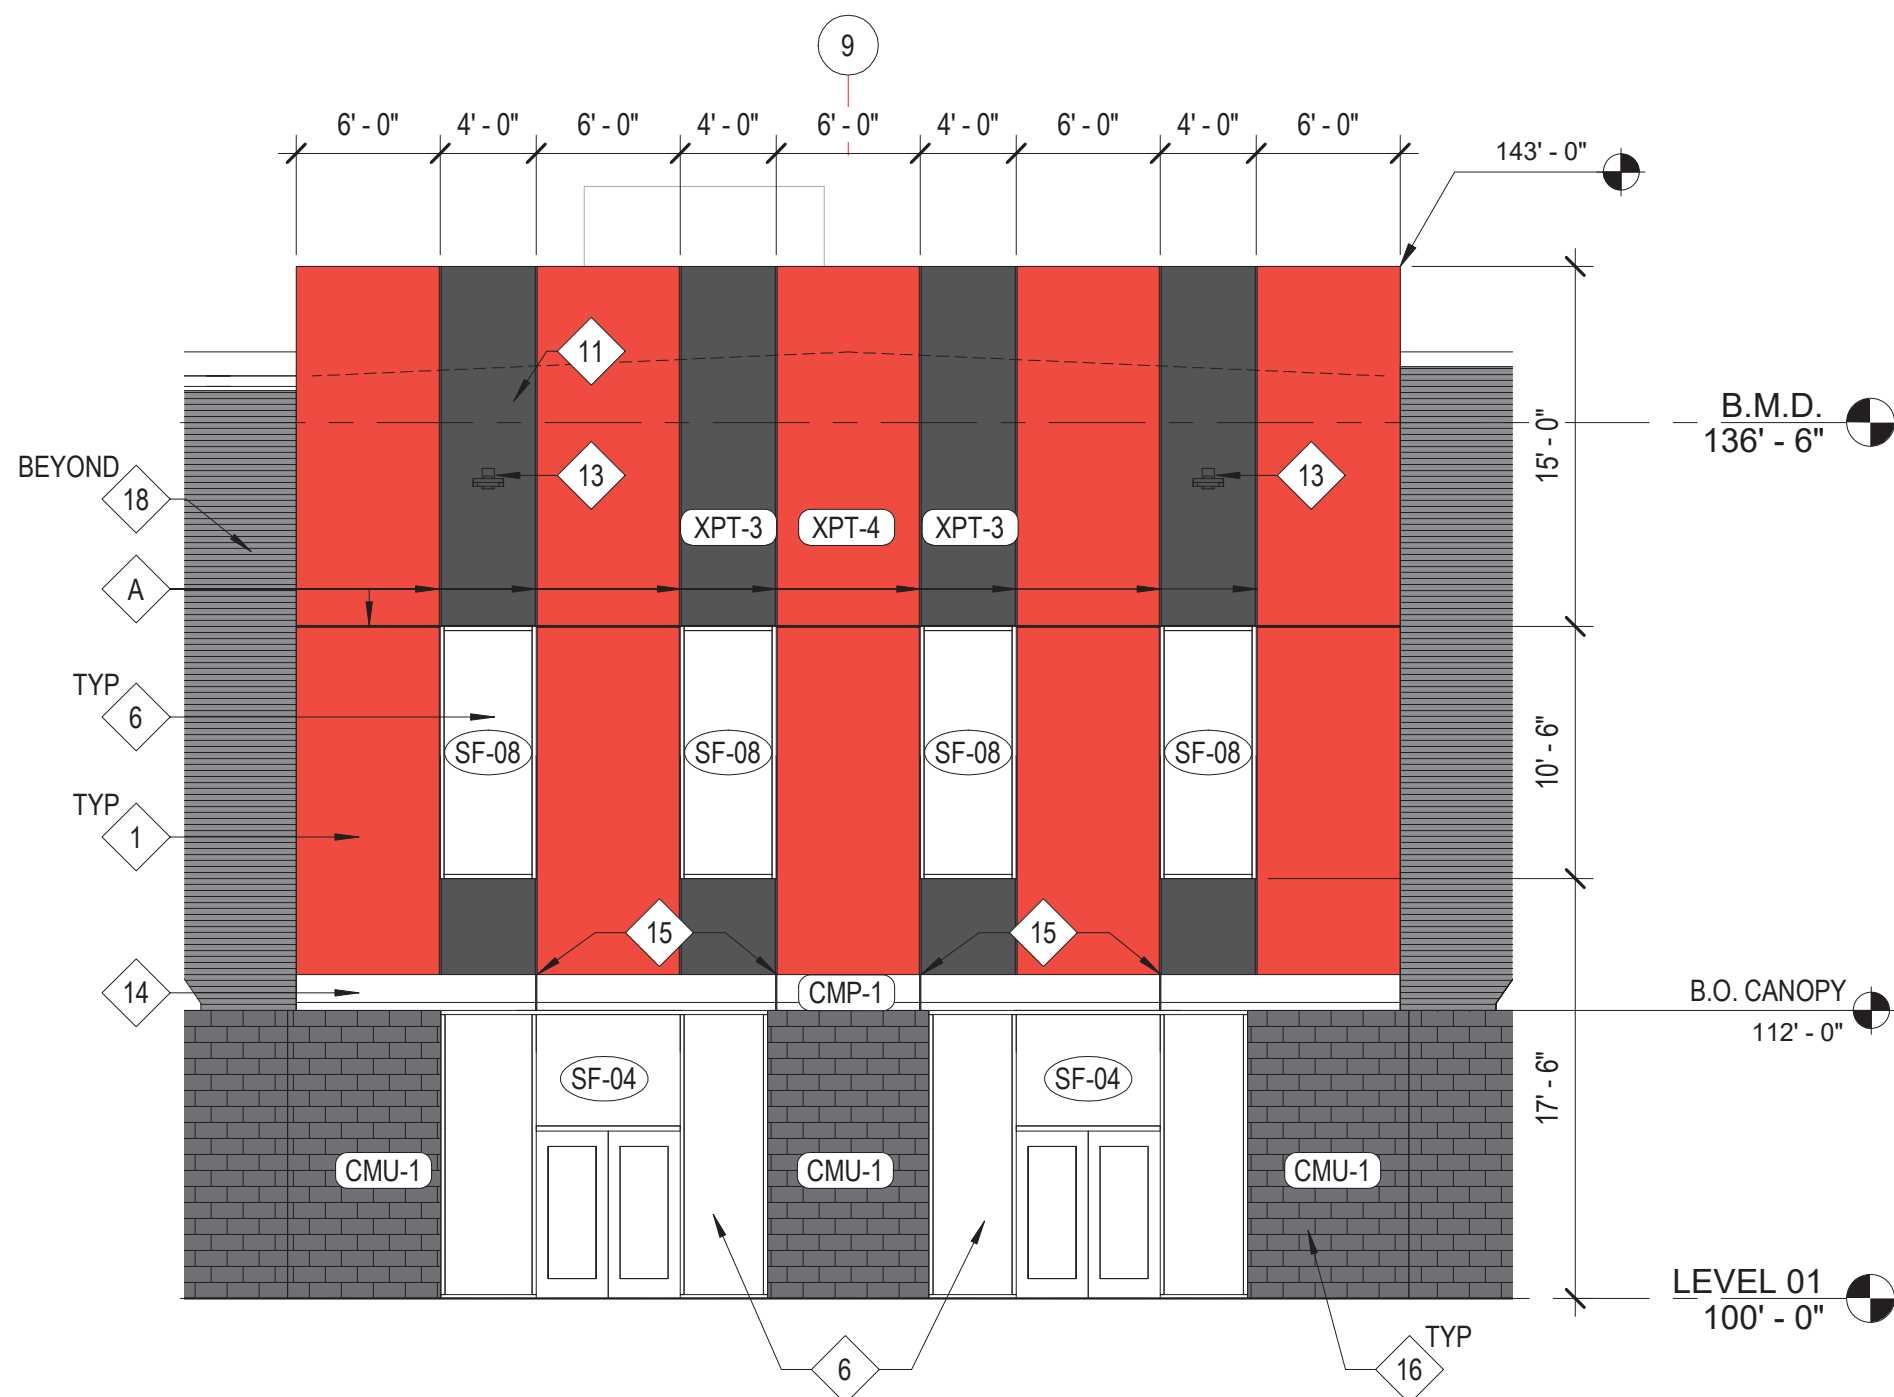


F3
A3.203
ENLARGED BUILDING ELEVATION - NORTH - ENTRY (CENTER)
1/8" = 1'-0"

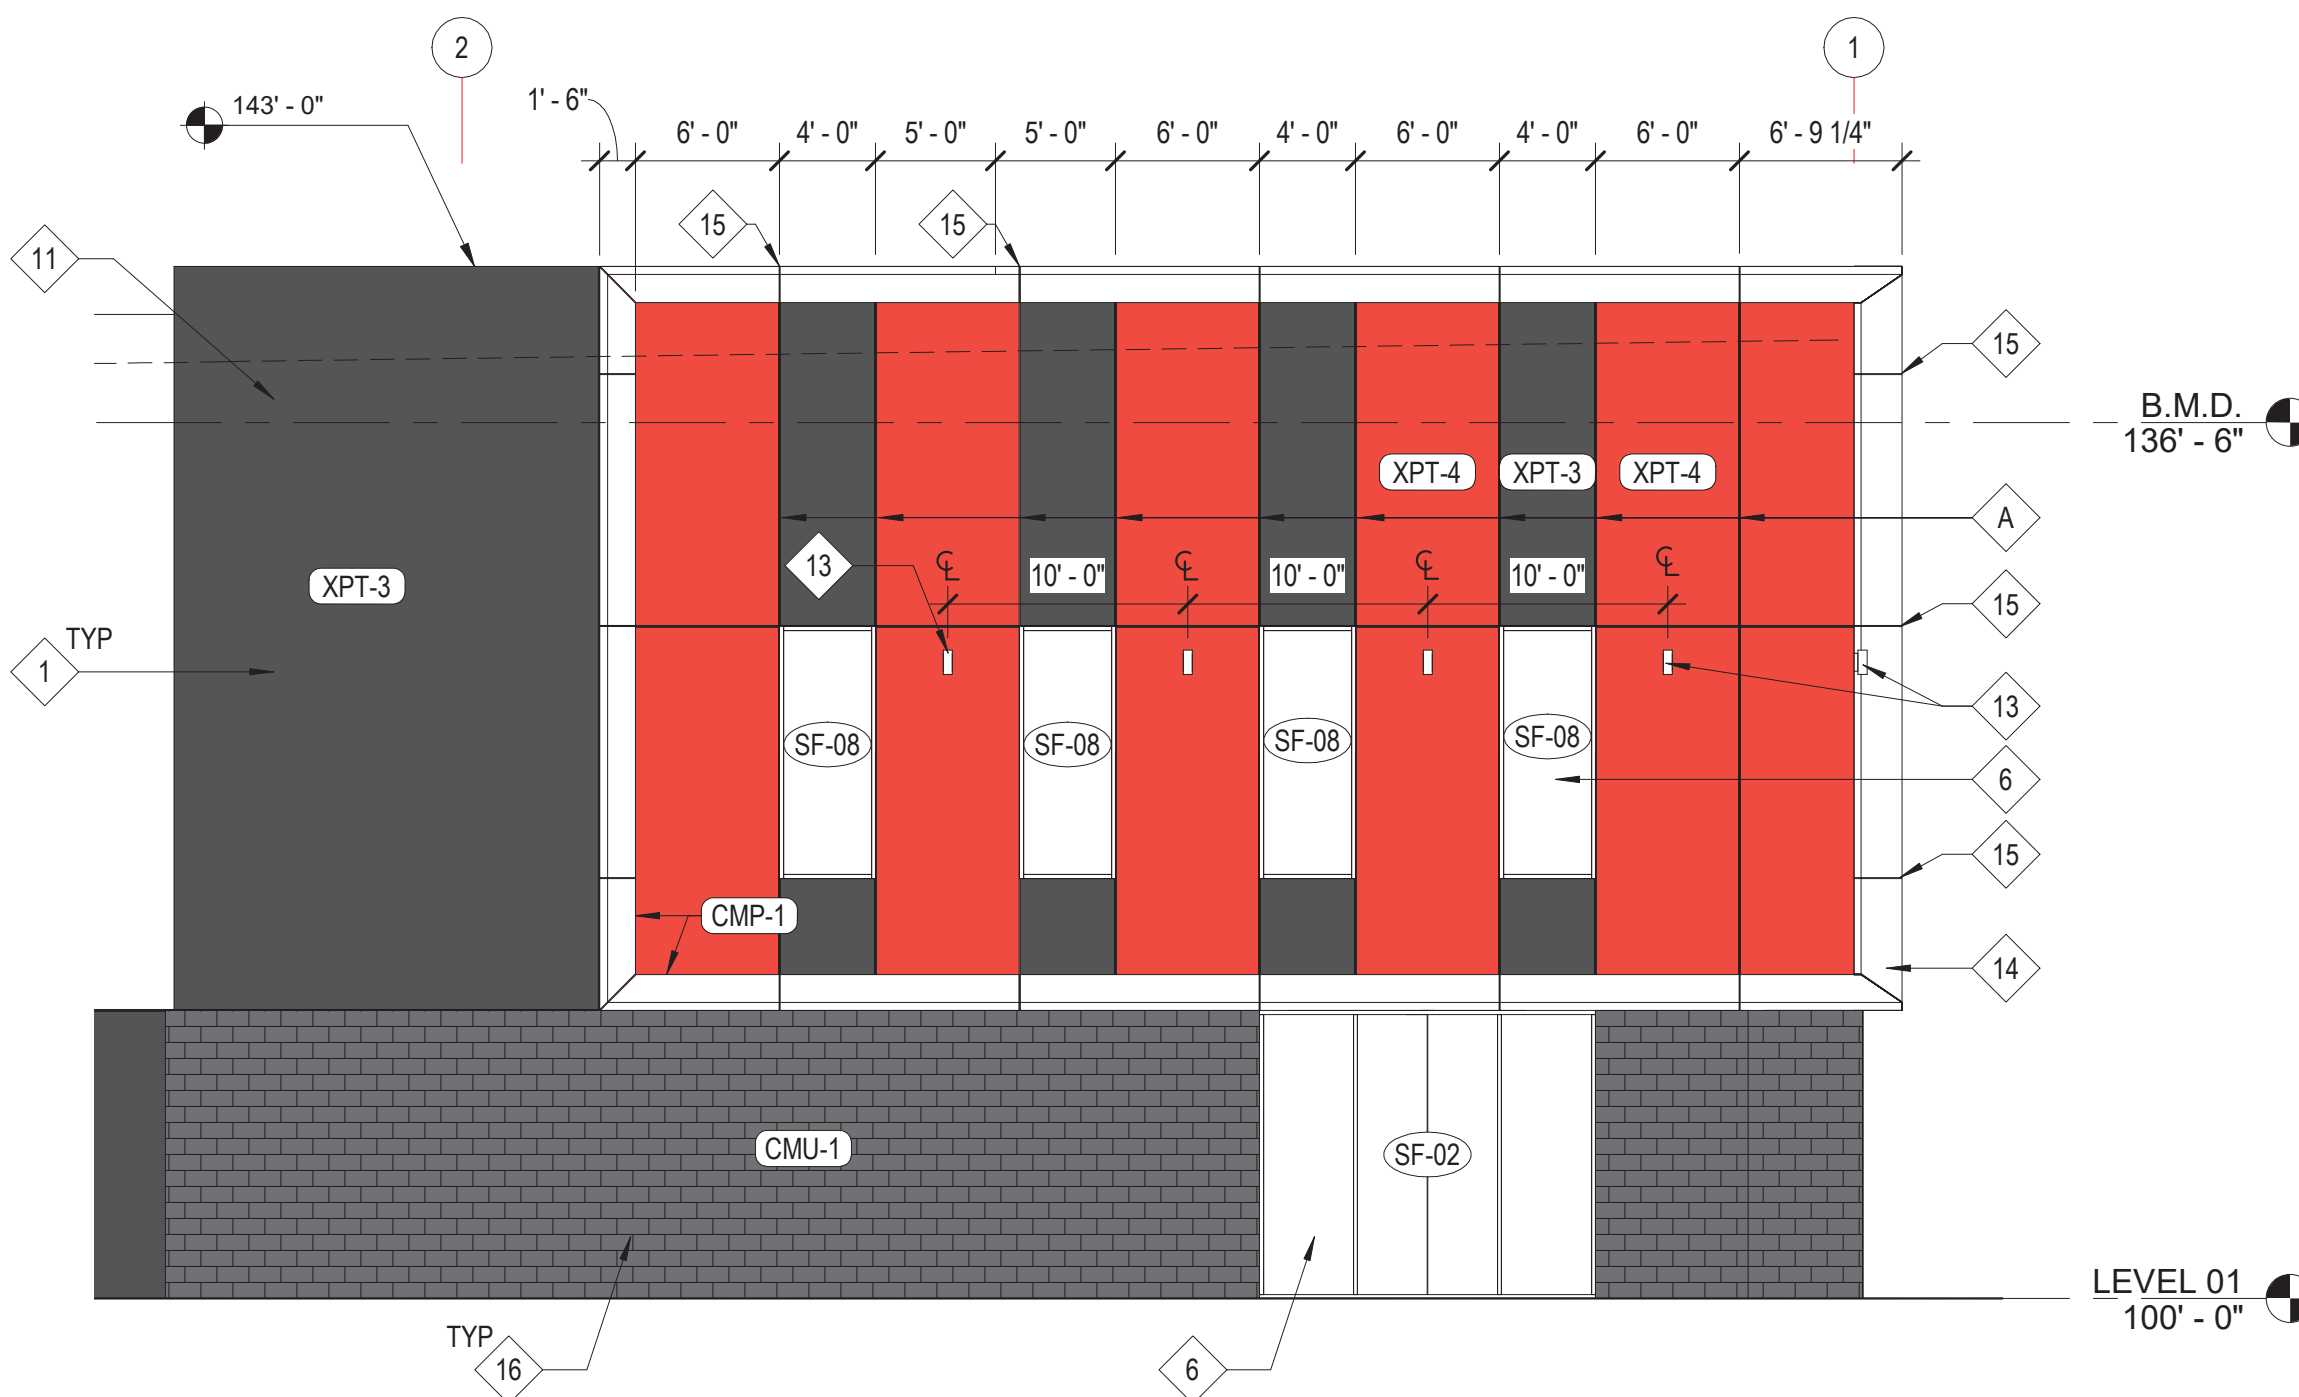


D3
A3.203
ENLARGED BUILDING ELEVATION - NORTH - ENTRY
1/8" = 1'-0"

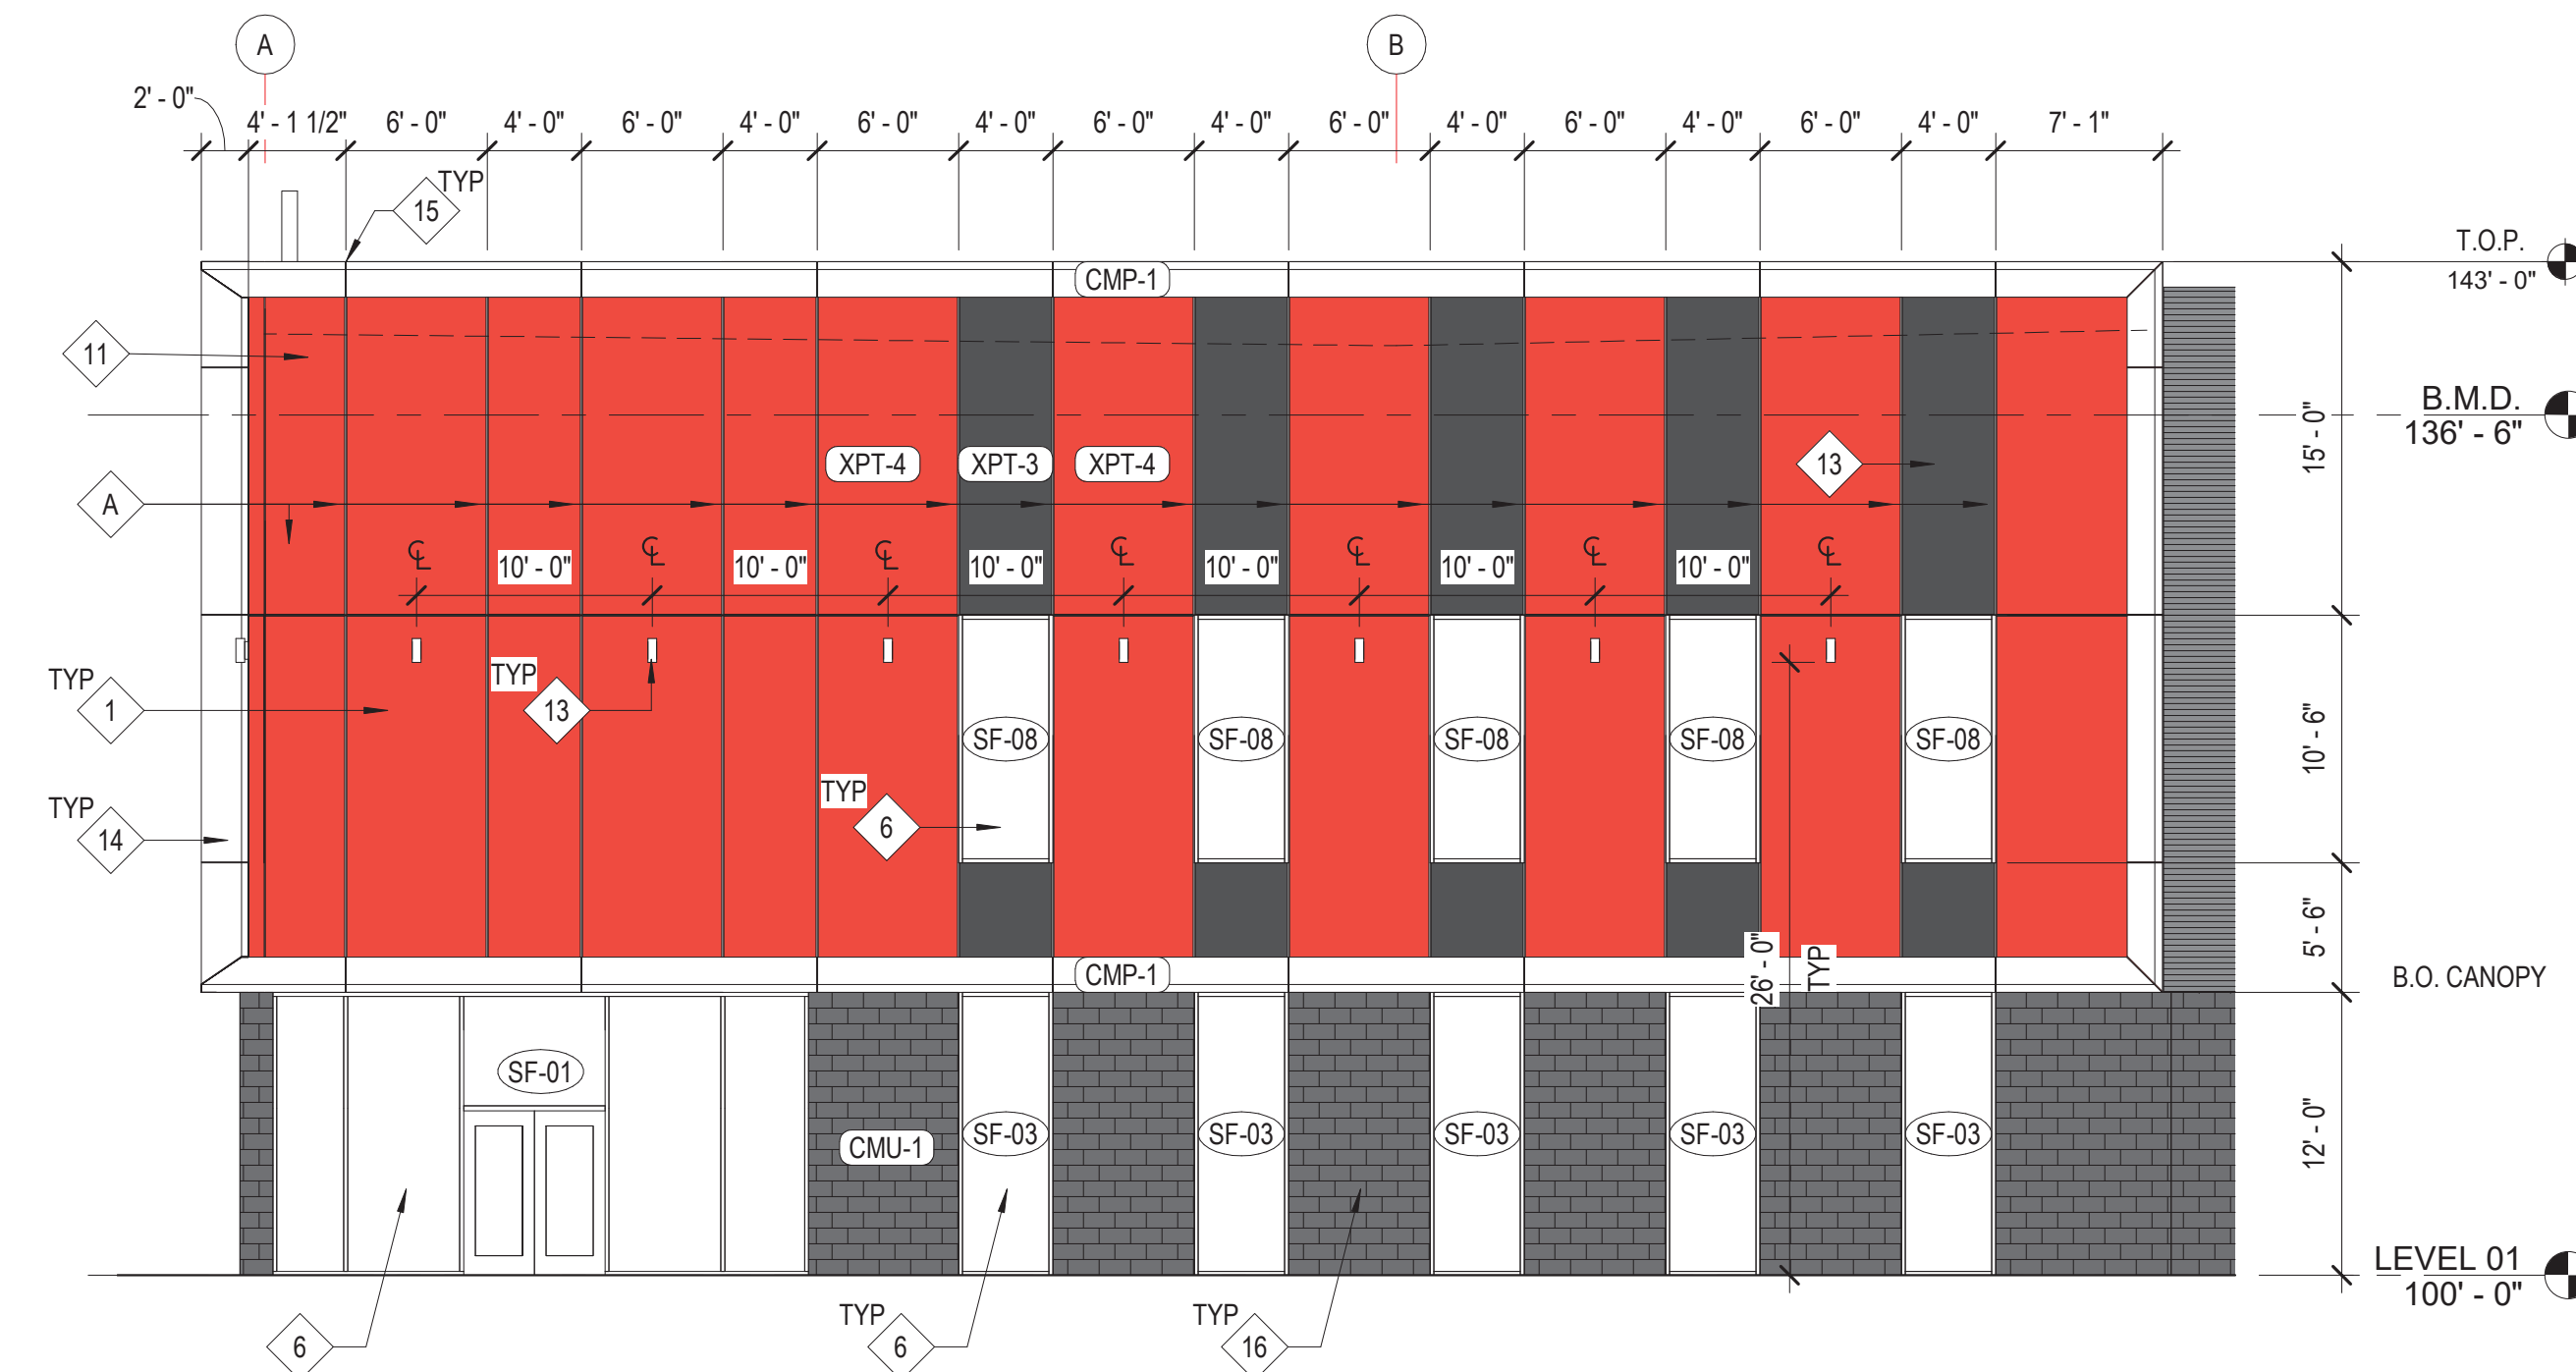


A3
A3.203
ENLARGED BUILDING ELEVATION - WEST - ENTRY
1/8" = 1'-0"

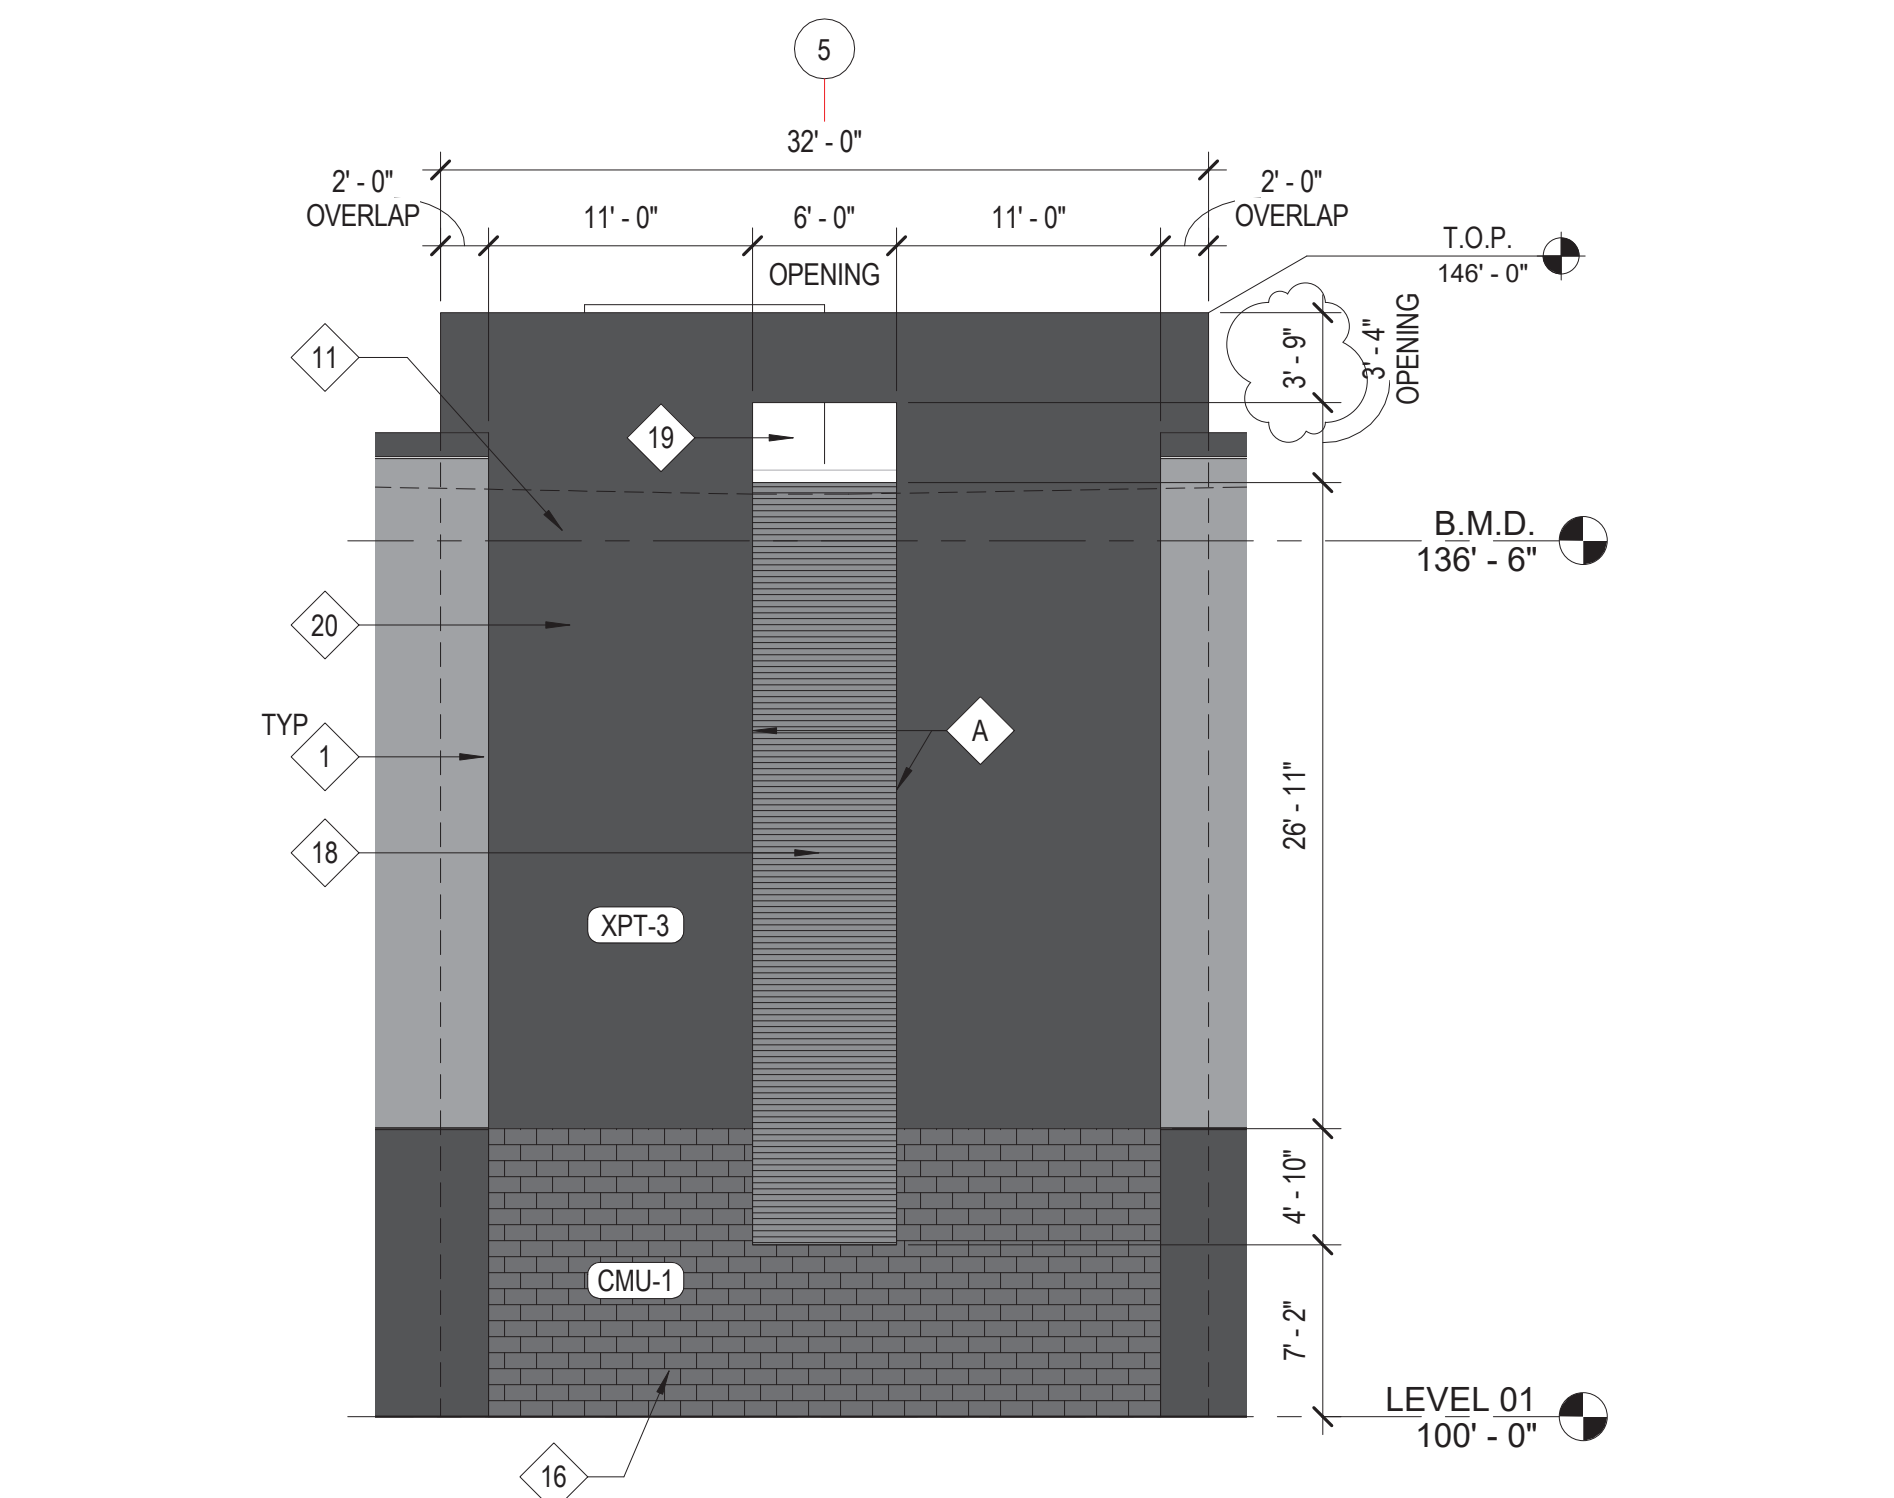

F1
A3.203
ENLARGED BUILDING ELEVATION - NORTH - TYPICAL OVERLAP PANEL
1/8" = 1'-0"

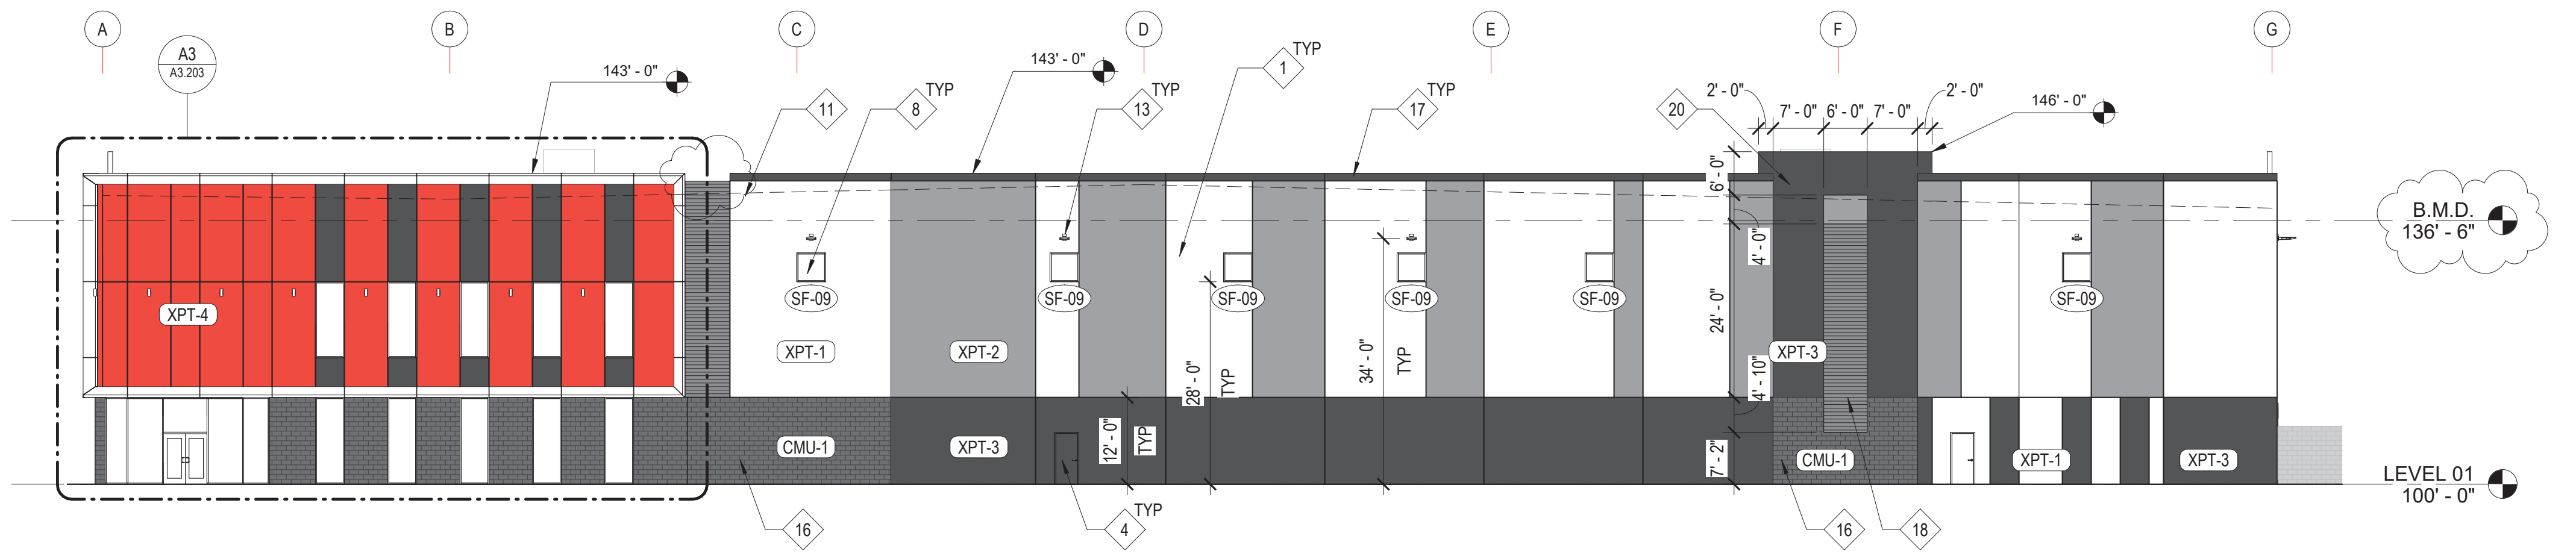

A2
A3.203
BUILDING ELEVATION - WEST
1/16" = 1'-0"

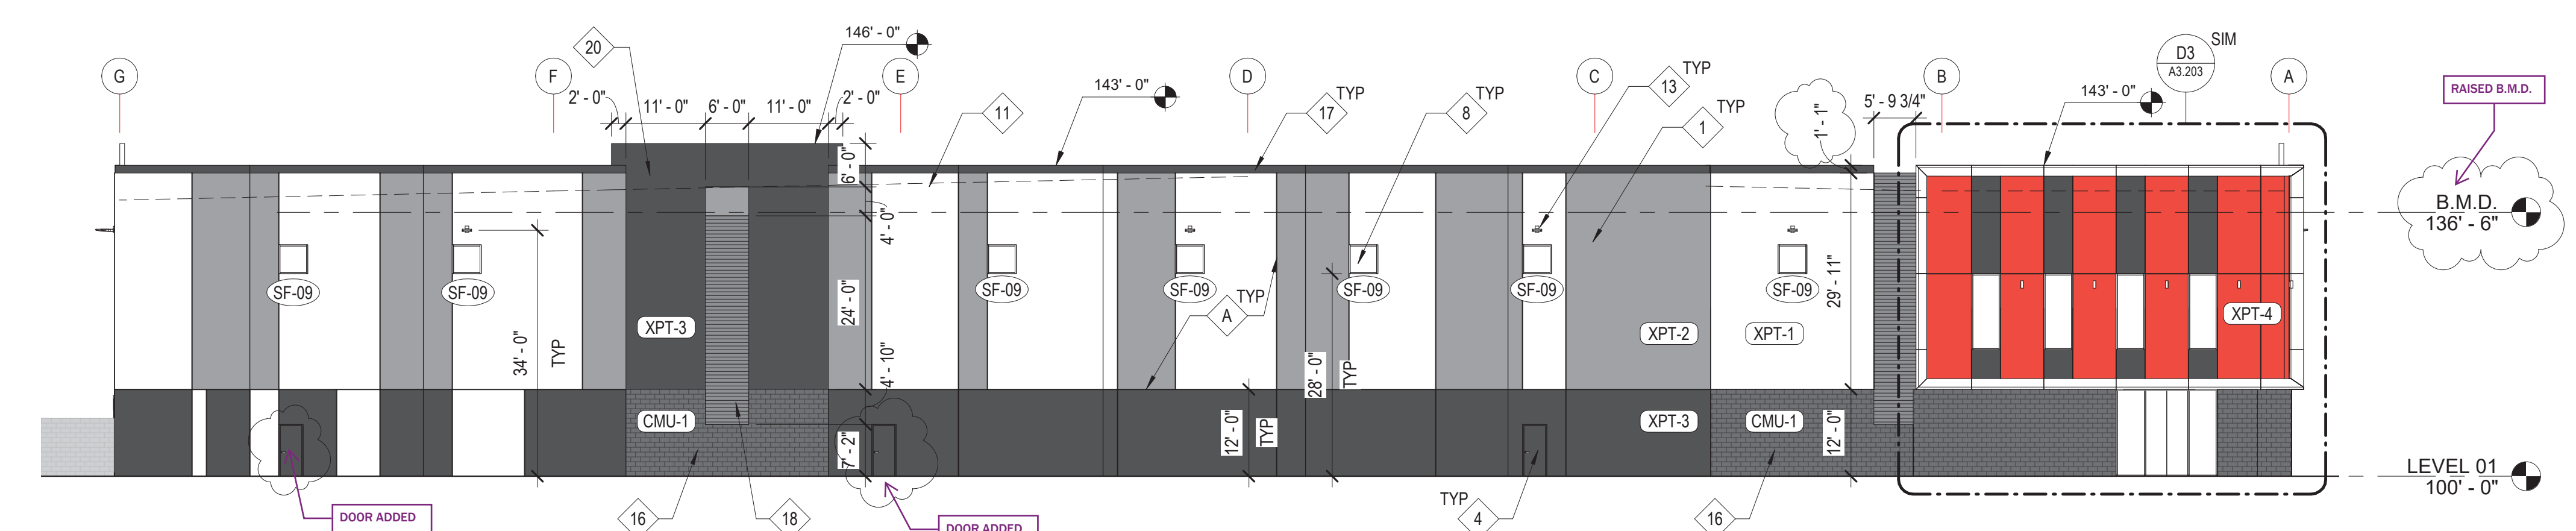

A1
A3.203
BUILDING ELEVATION - EAST
1/16" = 1'-0"

CLAYCO
THE ART & SCIENCE OF BUILDING
2199 INNERBELT BUSINESS CENTER DRIVE
ST. LOUIS, MISSOURI 63114
PH 314.429.5100 FX 314.429.3137

Lamar Johnson
Collaborative
2199 INNERBELT BUSINESS CENTER DRIVE
ST. LOUIS, MISSOURI 63114
PH 314.429.5100

REGISTERED ARCHITECT
CERTIFICATE NO.
66506
KAPIL KHANNA
DESIGNED
ARIZONA U.S.A.
04.22.2022



CRG
INTEGRATED
REAL ESTATE
SOLUTIONS

THE CUBES AT MESA - BLDG A
E PECOS RD & S CRISION RD, MESA, AZ 85212

DRAWING ISSUE	
DESCRIPTION	DATE
DESIGN REVIEW	03.21.2022
1ST REVIEW COMMENTS	04.22.2022
DRAWING TITLE BUILDING ELEVATIONS - EAST & WEST	
DRAWING NO. A3.203	
Job # 006329	

EXTERIOR ELEVATION NOTES

GENERAL NOTES	LEGEND	KEYED NOTES	KEYED NOTES	NOTES
1. PROVIDE TCA GRADE 'X' PATCHING AT OFFICE AREA. ALL OTHER AREAS TO BE TCA GRADE 'B' PATCHING. 2. ALL DIMENSIONS ARE TO FACE OF CONCRETE OR ROUGH OPENING. SEE FLOOR PLANS, SECTIONS, AND ELEVATIONS. 3. ALL EXPOSED SIDES OF CONCRETE TILT-UP PANEL TO BE PAINTED. 4. CONCRETE FILLED BOLLARDS TO BE PAINTED "SAFETY YELLOW". 5. ALL EXTERIOR HOLLOW METAL DOORS, FRAMES AND OVERHEAD DOORS TO BE PAINTED TO MATCH ADJACENT WALL COLOR. 6. ALL TILT-UP DIMENSIONS TAKEN FROM CENTER OF REVEAL. 7. PROVIDE REVEAL AT TRANSITION OF PAINT COLOR (HORIZONTAL & VERTICAL). 8. SEE SHEET A3.501 FOR EXTERIOR CONCRETE PANEL JOINTS, U.N.O. 9. EXTERIOR SECTIONAL DOORS TO MATCH ADJACENT WALL COLOR. CUSTOM FACTORY FINISH. 10. DO NOT PROVIDE A REVEAL AT THE KNOCK OUT PANELS. 11. THE EXTERIOR FACING SURFACES OF THE TILT-UP PANELS BEHIND THE ALUMINUM WINDOW AND COMPOSITE METAL PANEL SYSTEMS MUST BE FULLY PAINTED PRIOR TO INSTALLATION OF THE SYSTEMS. UNPAINTED SURFACES MUST BE SUPPLEMENTED WITH AN APPLIED AIR AND MOISTURE BARRIER	XPT-1 - SHERWIN WILLIAMS COLOR, CLAYCO FLAGSTONE (518-4) XPT-2 - SHERWIN WILLIAMS COLOR, CLAYCO DOVER GRAY (518-5) XPT-3 - SHERWIN WILLIAMS COLOR, CLAYCO KNIGHTS ARMOR (518-6) XPT-4 - SHERWIN WILLIAMS COLOR, CLAYCO RED CMP-1 - COMPOSITE METAL PANEL, REYNOBOND - COLORWELD 500 SILVERSMITH CMU-1 - ARCHITECTURAL CMU, ATHENIA SPLIT FACE, MIDWEST BLOCK & BRICK, COLOR - EBONY	A "V" TYPE REVEAL IN CONC. TILT-UP PANEL	1 CONCRETE TILT-UP PANEL, PAINTED 2 CONCRETE DRIVE-IN RAMP WITH CONCRETE RETAINING WALL AND GALV. STL. PIPE GUARDRAIL 3 14'-0" W x 16'-0" H OH DRIVE-IN DOOR, PREFINISHED TO MATCH ADJACENT WALL COLOR. SEE OH DOOR SCHEDULE 4 HOLLOW METAL DOOR AND FRAME, PAINTED TO MATCH ADJACENT WALL COLOR. SEE DOOR SCHEDULE 5 GALVANIZED STEEL DOCK STAIR 6 GRAY TINTED WINDOWS IN BLACK ALUMINUM STOREFRONT 7 9'-0" W x 10'-0" H OH DOCK DOOR, PREFINISHED TO MATCH ADJACENT WALL COLOR. SEE OH DOOR SCHEDULE 8 4' X 4' CLERESTORY WINDOW 9 BIKE RACK 10 NOT USED 11 ROOF LINE BEYOND 12 EXTERIOR EGRESS LIGHTING FIXTURE, CENTER ABOVE DOOR. SEE ELECTRICAL 13 WALL PACK LIGHTING FIXTURE, SEE ELECTRICAL 14 COMPOSITE METAL PANEL ON METAL STUD FRAMING WITH MITERED CORNERS 15 COMPOSITE METAL PANEL JOINT, SEE DTL. E1/A3.605 16 SPLIT-FACED CMU VENEER 17 TEXTURED CONCRETE FORMLINER CORNICE 18 TEXTURED CONCRETE FORMLINER RECESS 19 OVERFLOW SCUPPER 20 CONCRETE LAP PANEL	BUILDING B ELEVATIONS ARE THE SAME AS BUILDING A BUT OPPOSITE. REFER TO SHEETS AA2.101 & AB2.101 FOR ELEVATION REFERENCES.

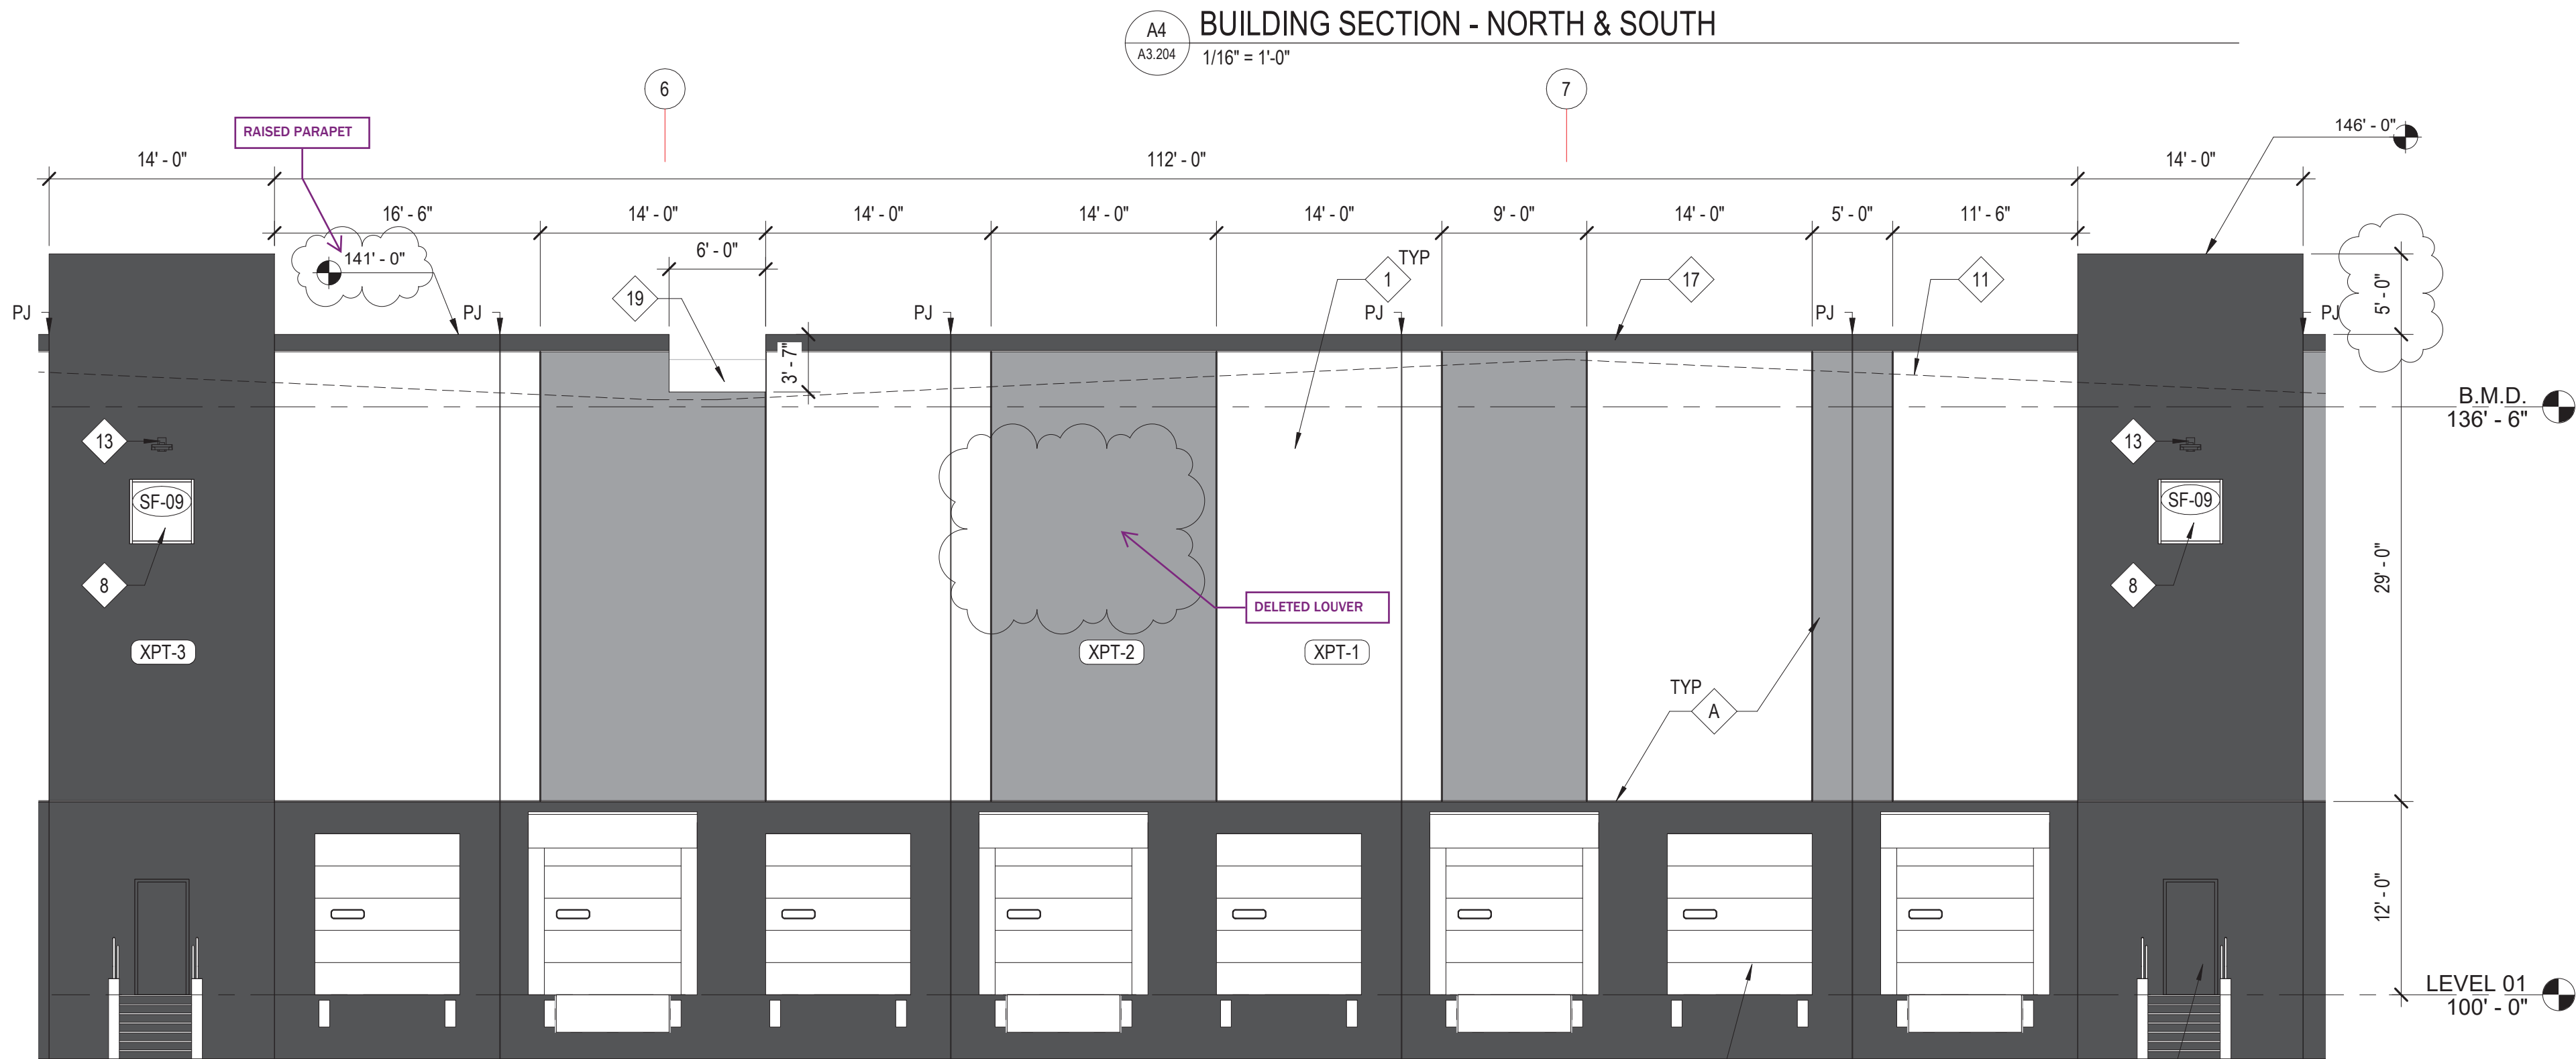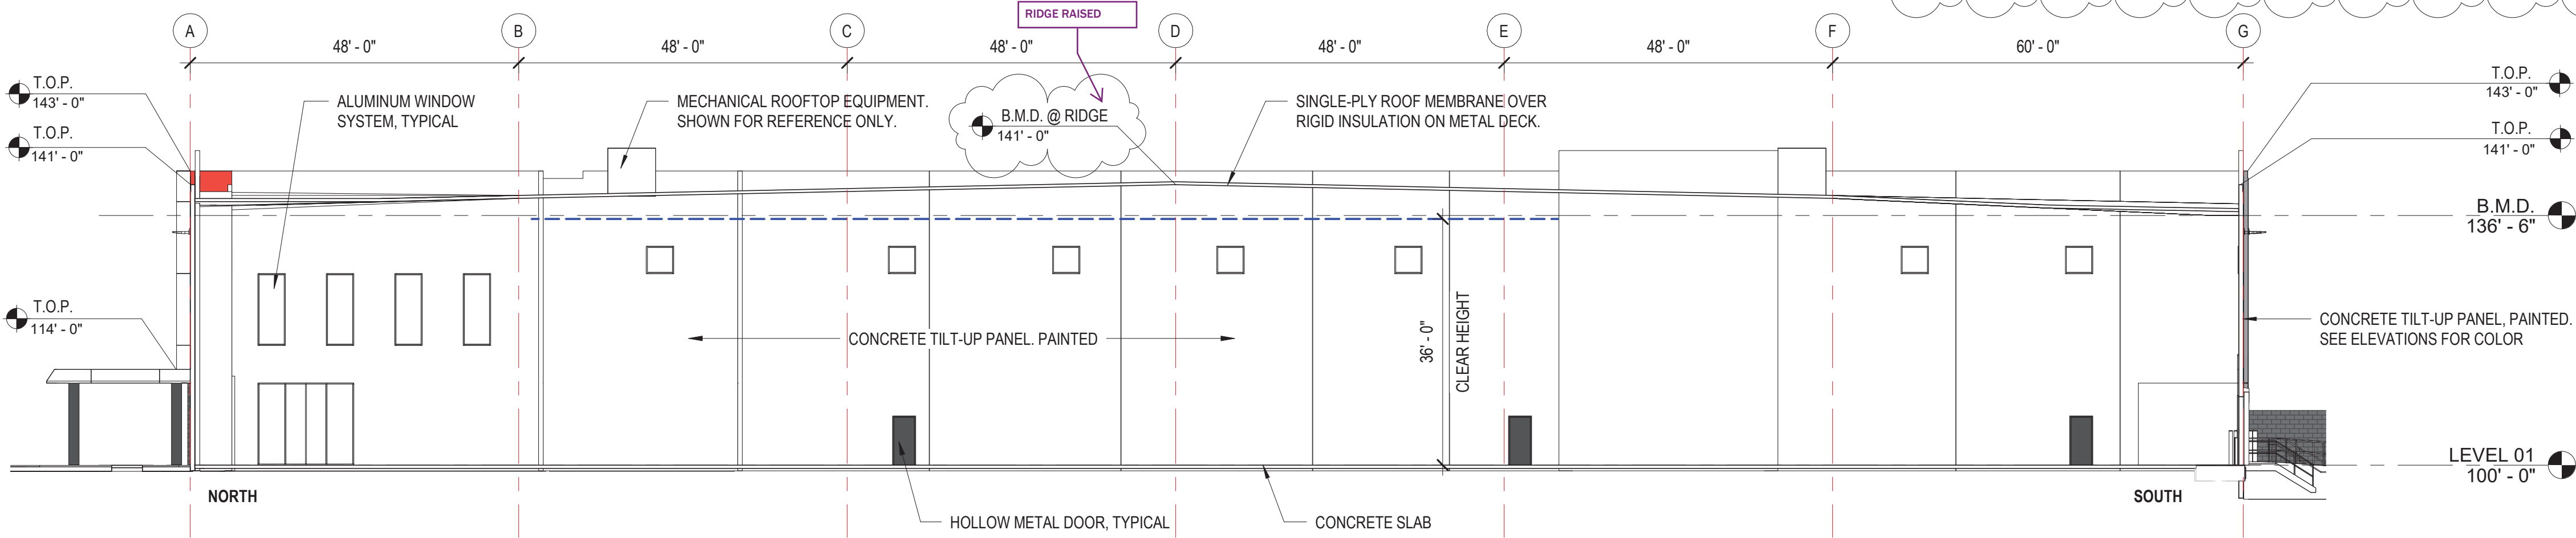




Corner Entrance View



Center Entrance View



Night View

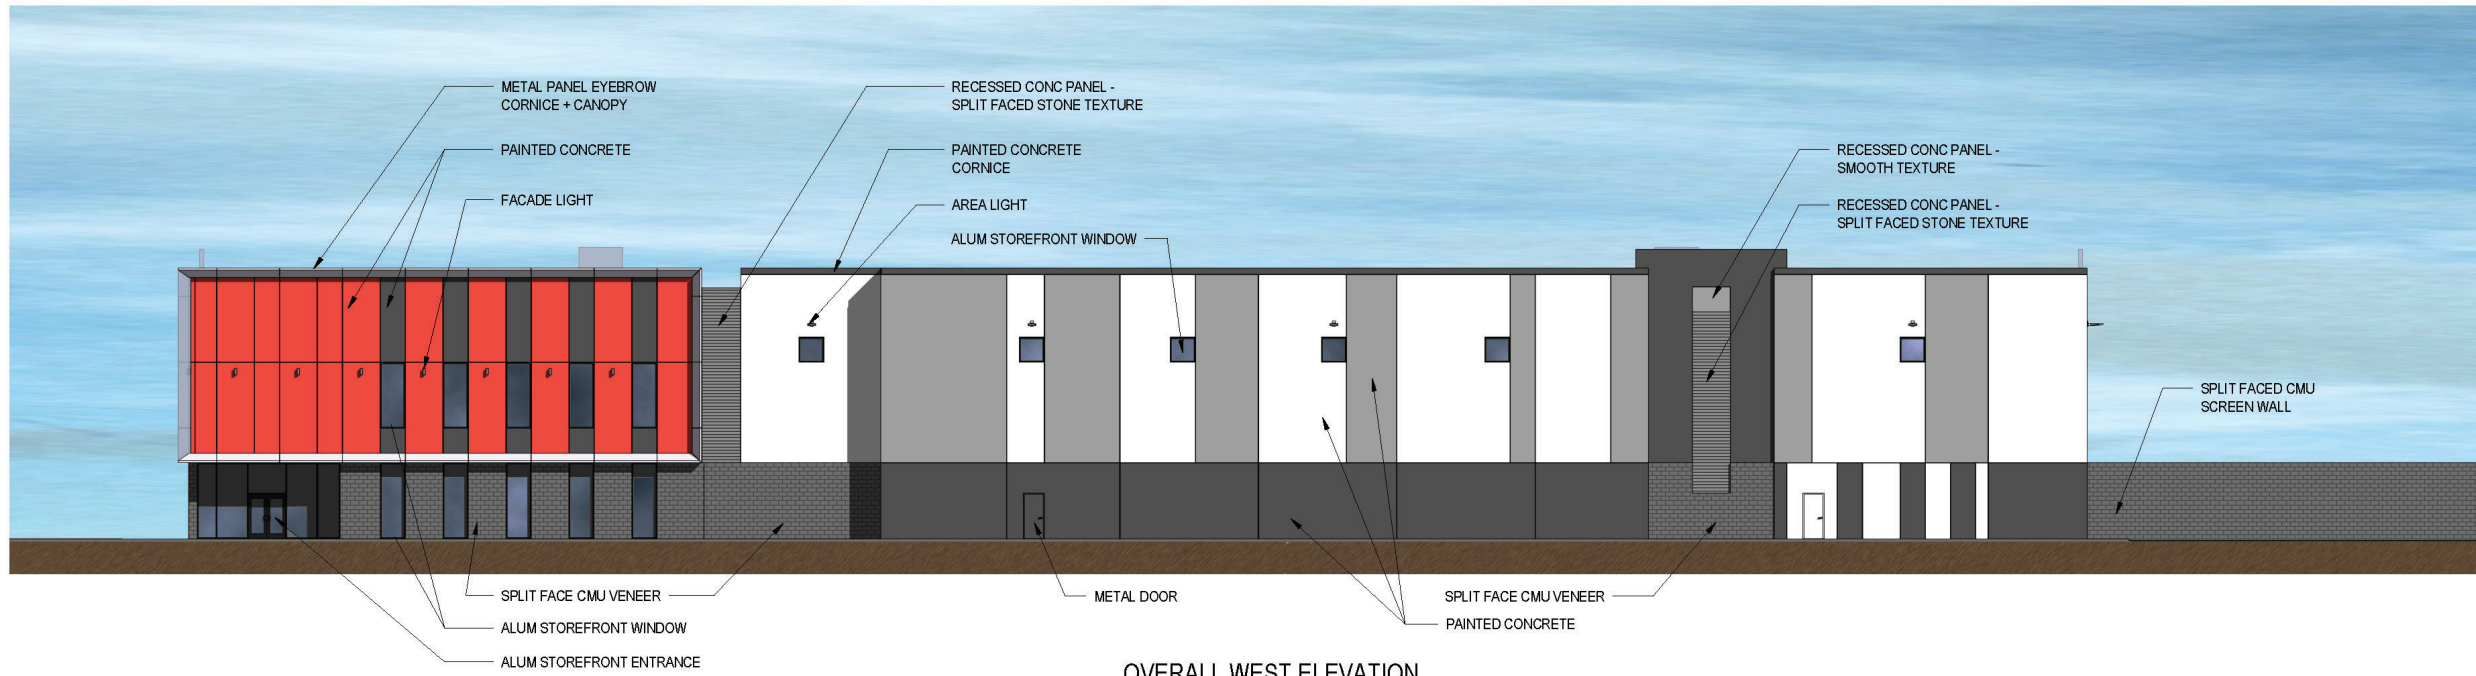

OVERALL WEST ELEVATION
1/16" = 1'-0"

NOTE: THESE DRAWINGS
ILLUSTRATE BUILDING A.
BUILDING B IS THE SAME BUT
OPPOSITE-HAND. THE
BUILDINGS ARE MIRRORED
ALONG THE SHARED
EAST/WEST BOUNDARY.



ENLARGED NORTH ELEVATION - RIGHT
1/16" = 1'-0"



ENLARGED NORTH ELEVATION - LEFT
1/16" = 1'-0"



OVERALL NORTH ELEVATION
1" = 30'-0"

CLAYCO
THE ART & SCIENCE OF BUILDING
2199 INNERBELT BUSINESS CENTER DRIVE
ST. LOUIS, MISSOURI 63114
PH 314.423.8100 FAX 314.423.1337

Lamar Johnson Collaborative
2199 INNERBELT BUSINESS CENTER DRIVE
ST. LOUIS, MISSOURI 63114
PH 314.423.8100

CRG INTEGRATED
REAL ESTATE
SOLUTIONS


THE CUBES AT MESA
E PECOS RD & S CRISMON RD, MESA, AZ 85212

DRAWING ISSUE
DESCRIPTION DATE
DESIGN REVIEW 3-21-2022

DRAWING TITLE
BUILDING ELEVATIONS
COLORED



DRAWING NO.
+A3-01

Job # 006329

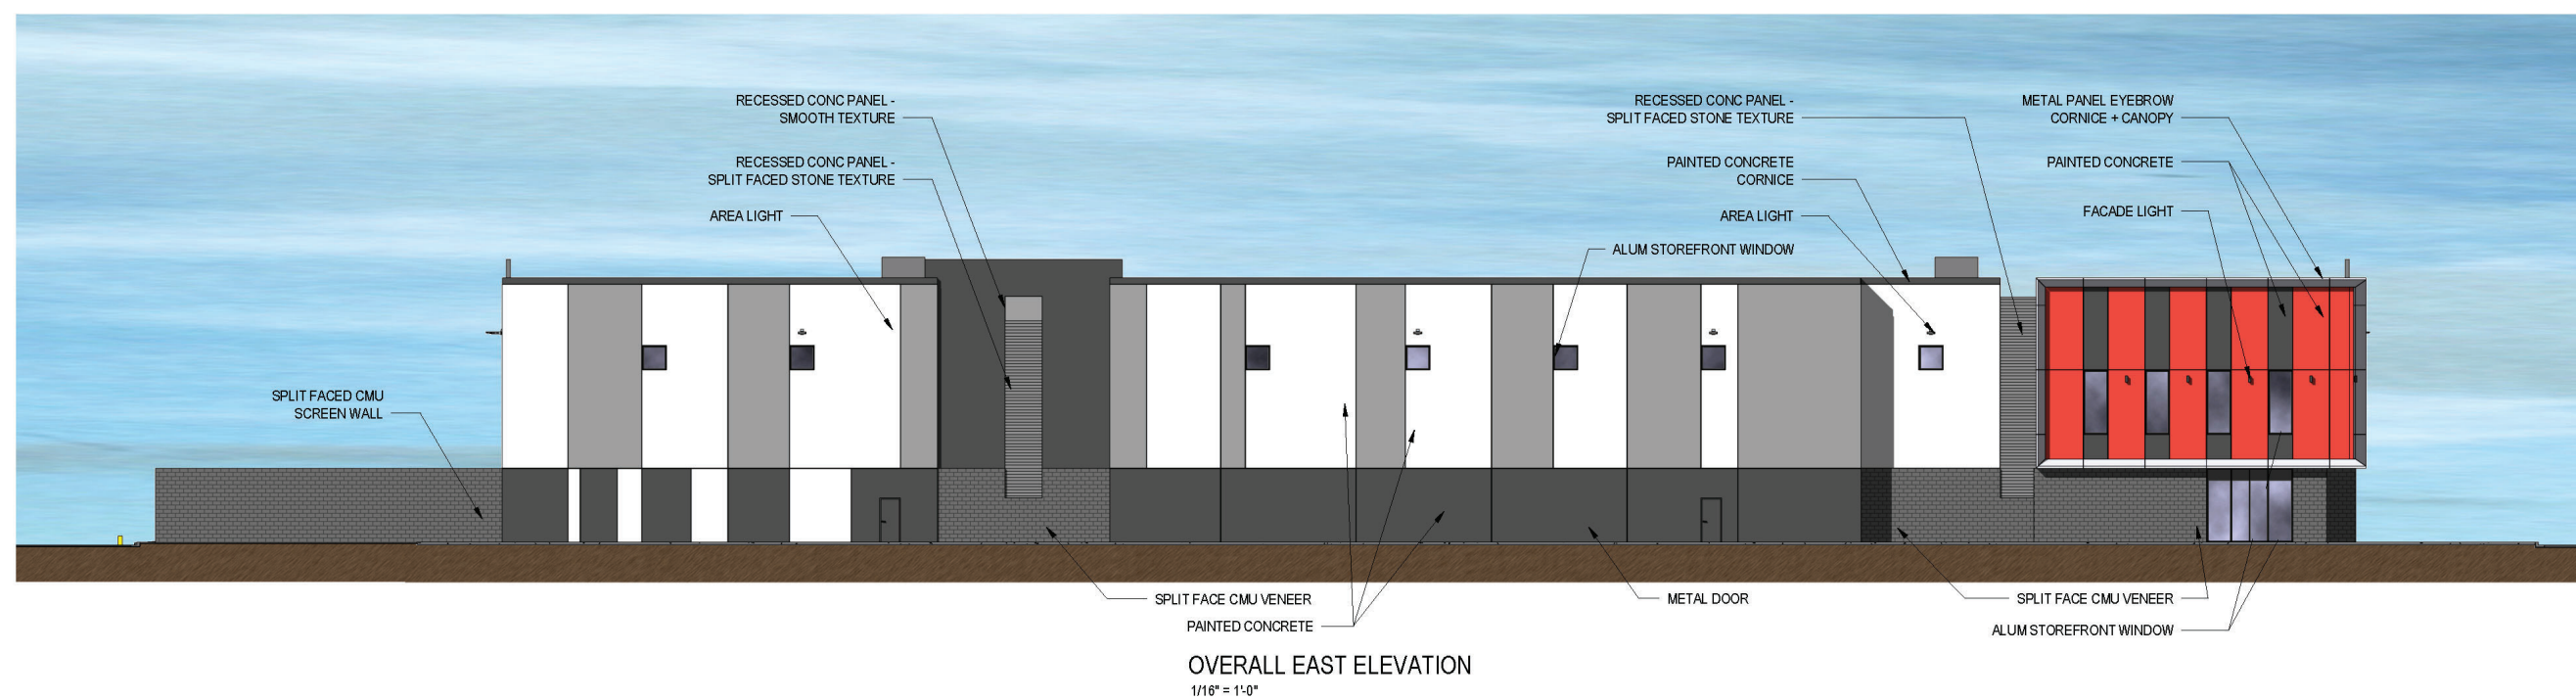

REVISIONS

1. Dock Doors color changed to Knights Armor.
2. Ventilation louvers removed on South Elevation.

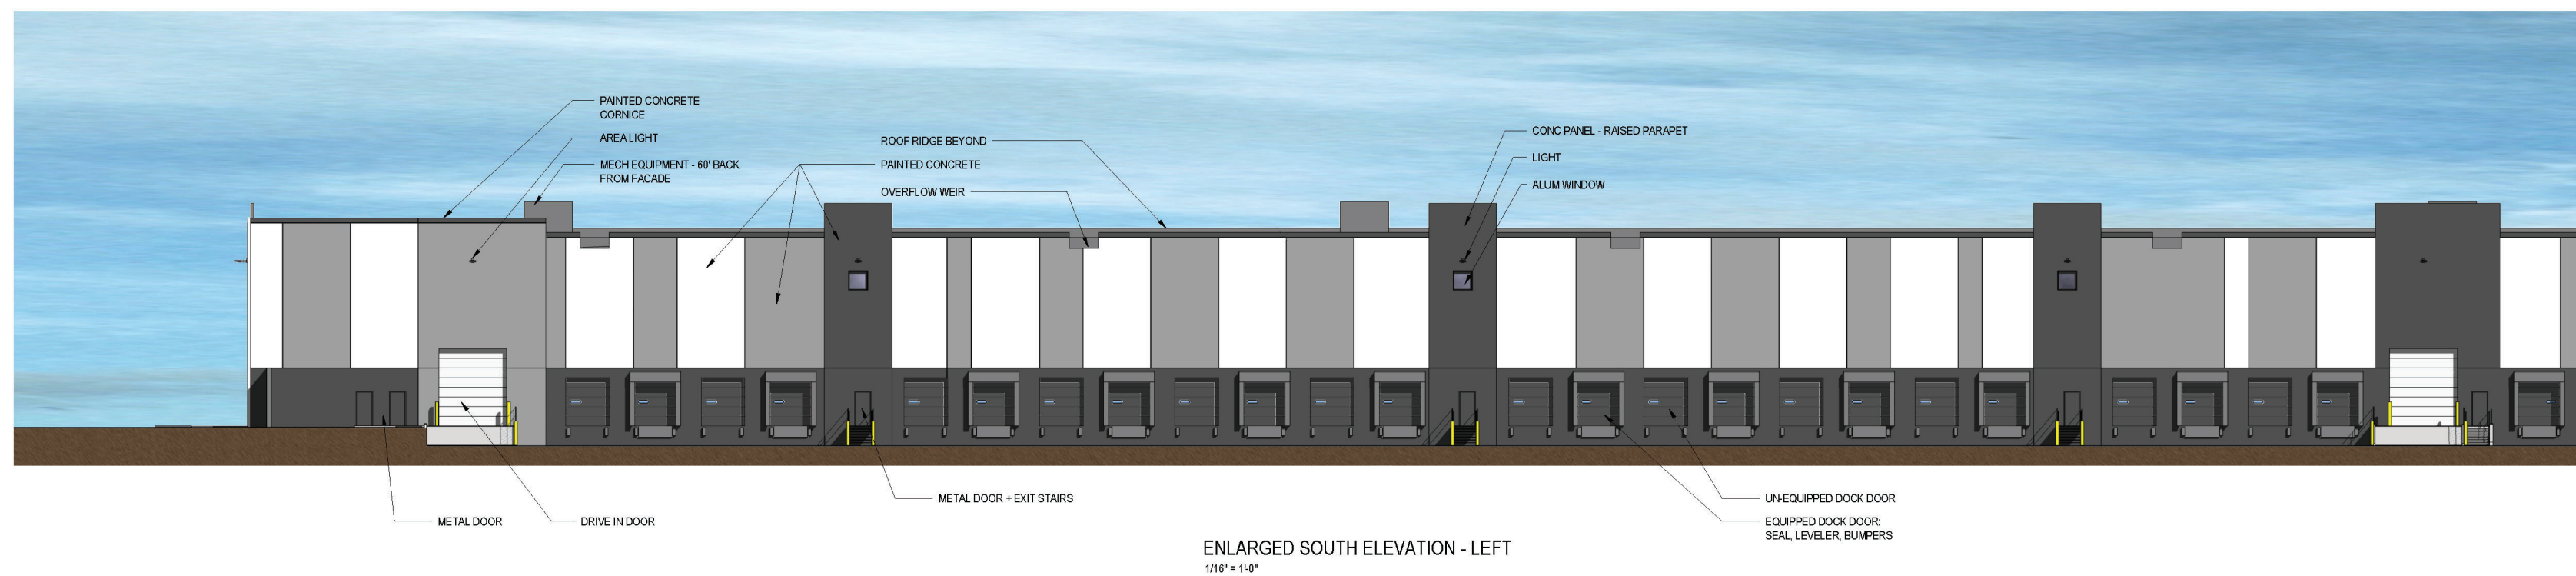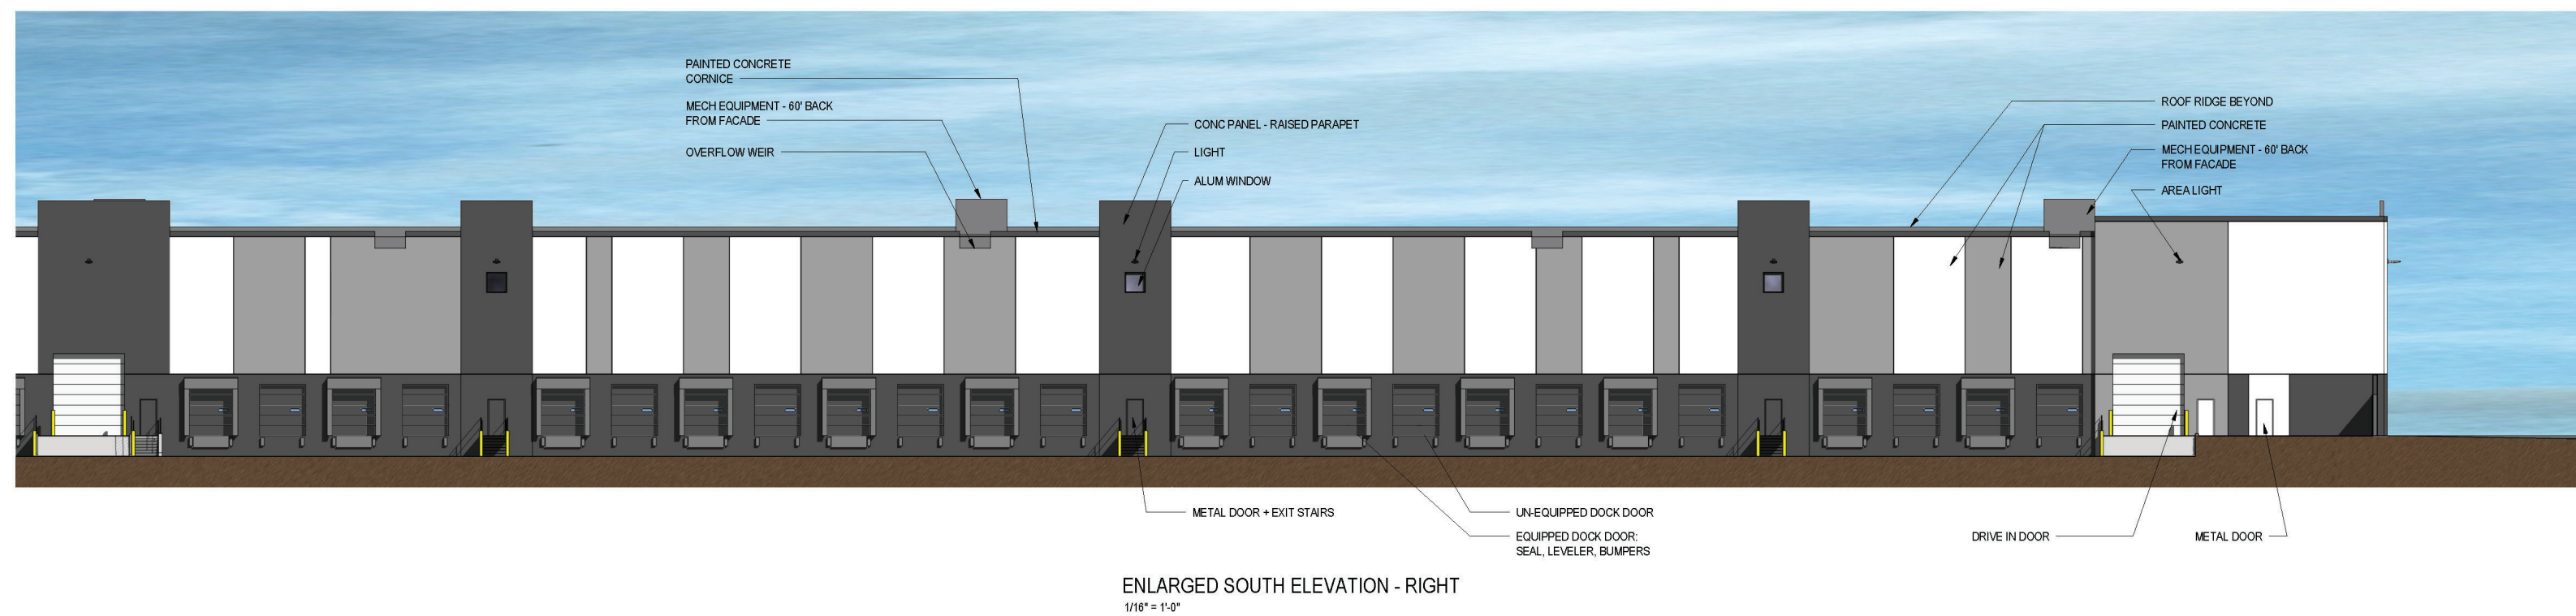

CLAYCO
THE ART & SCIENCE OF BUILDING
2199 INNERBELT BUSINESS CENTER DRIVE
ST. LOUIS, MISSOURI 63114
PH 314.425.5100 FX 314.429.3137

Amar Johnson
Collaborative 

2199 INNERBELT BUSINESS CENTER DRIVE
ST. LOUIS, MISSOURI 63114
Ph 314.429.1010



ERG | INTEGRATED
REAL ESTATE
SOLUTIONS

THE CUBES AT MESA
E PECOS RD & S CRISMON RD, MESA, AZ 85212

[illegible]

DRAWING TITLE
 BUILDING ELEVATIONS
 COLORED

+A3-02

006329



NORTH ELEVATION DETAIL - PECOS ROAD FRONTAGE
1/8" = 1'-0"



WEST ELEVATION DETAIL - CRISMON ROAD FRONTAGE
1/8" = 1'-0"



NORTH ELEVATION DETAIL - PECOS ROAD FRONTAGE
1/8" = 1'-0"



NORTH ELEVATION DETAIL - PECOS ROAD FRONTAGE
1/8" = 1'-0"

NOTE: THESE DRAWINGS ILLUSTRATE BUILDING A. BUILDING B IS THE SAME BUT OPPOSITE-HAND. THE BUILDINGS ARE MIRRORED ALONG THE SHARED EAST/WEST BOUNDARY.

CLAYCO
THE ART & SCIENCE OF BUILDING
2199 INHERBELT BUSINESS CENTER DRIVE
ST. LOUIS, MISSOURI 63114
PH: 314.423.8100 FAX: 314.423.1337

Lamar Johnson Collaborative
2199 INHERBELT BUSINESS CENTER DRIVE
ST. LOUIS, MISSOURI 63114
PH: 314.423.8100 FAX: 314.423.1337

CRG INTEGRATED REAL ESTATE SOLUTIONS

THE CUBES AT MESA - BUILDING A
E PECOS RD & S CRISMON RD, MESA, AZ 85212

DRAWING ISSUE
DESCRIPTION DATE
DESIGN REVIEW 3-21-2022

DRAWING TITLE
ENLARGED ELEVATION DETAILS
COLORED

DRAWING NO.
+A3-03

Job # 006329