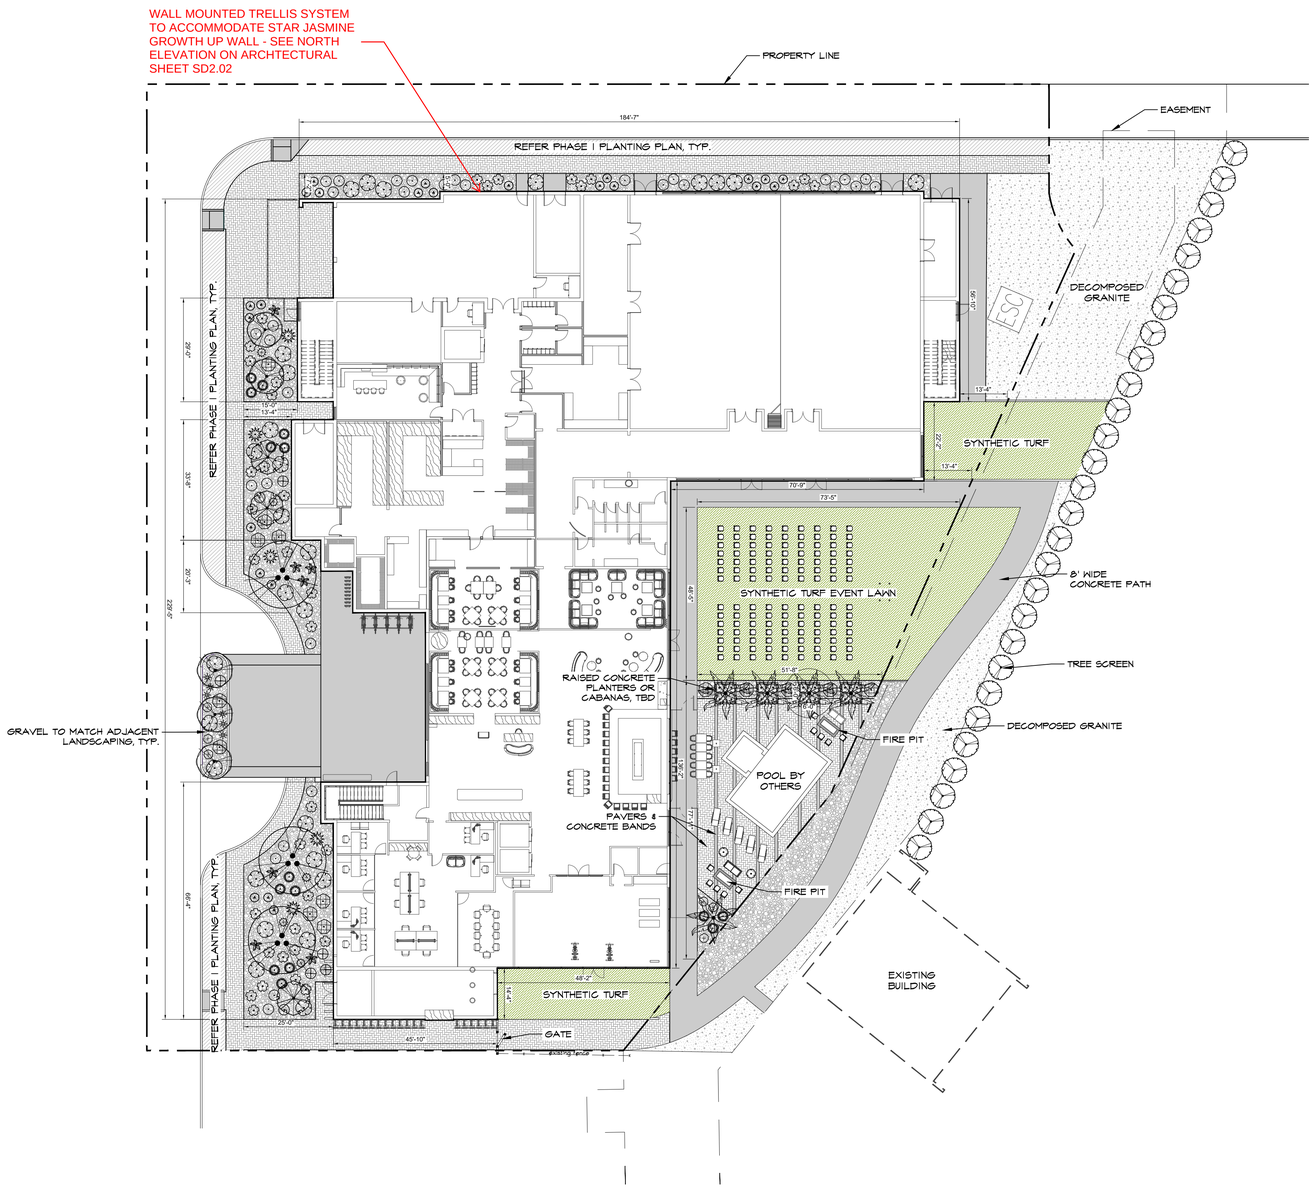

PLANT SCHEDULE

SYMBOL	BOTANICAL / COMMON NAME	CONT	QTY	SHADE SF.	SHADE SF. MULTIPLED
TREES					
	LAGERSTROEMIA INDICA / CRAPE MYRTLE	24"BOX	5	80 SF.	400 SF.
	PARKINSONIA X 'DESERT MUSEUM' / DESERT MUSEUM PALO VERDE	36" BOX	3	276 SF.	829 SF.
	PHOENIX DACTYLIFERA / RESORT STYLE DATE PALM	24" BOX	5	148 SF.	738 SF.
	PRUNUS CAROLINIANA 'COMPACTA' / COMPACT CAROLINA CHERRY	24"BOX	28	40 SF.	1,114 SF.
	VITEX AGNUS-CASTUS / CHASTE TREE	24" BOX	3	214 SF.	214 SF.
					TOTAL SF.
SYMBOL	BOTANICAL / COMMON NAME	SIZE	QTY		3,295 SF.
SHRUBS					
	AGAVE AMERICANA 'MEDIO-PICTA ALBA' / STRIPED CENTURY PLANT	5 GAL	7		
	AGAVE PARRYI TRUNCATA / ARTICHOKE PARRY'S AGAVE	5 GAL	6		
	HESPERALOE PARVIFLORA / RED YUCCA	5 GAL	5		
	LANTANA SELLOWIANA / PURPLE LANTANA	1 GAL	28		
	RHAPHIOLEPIS INDICA 'PINKIE' / INDIAN HAWTHORNE	5 GAL	14		
	ROSA ACICULARIS 'NOARE' TM / RED FLOWER CARPET ROSE	5 GAL	33		
CACTI					
	ECHINOCACTUS GRUSONII / GOLDEN BARREL CACTUS	5 GAL	5		
GRASSES					
	MUHLENBERGIA CAPILLARIS 'REGAL MIST' TM / MUHLY	5 GAL	15		
	MUHLENBERGIA LINDHEIMERI 'AUTUMN GLOW' / AUTUMN GLOW MUHLY	5 GAL	5		
	PENNISETUM ALOPECUROIDES 'HAMELN' / HAMELN DWARF FOUNTAIN GRASS	5 GAL	24		
ANNUALS/PERENNIALS					
	DELOSPERMA NUBIGENUM / ICE PLANT	1 GAL	53		
	HEMEROCALLIS X 'STELLA DE ORO' / STELLA DE ORO DAYLILY	1 GAL	6		
	SALVIA GREGGII / AUTUMN SAGE	1 GAL	2		
	ROCK MULCH TO BE A MINIMUM OF 1", AND 3" THICK, PER CITY. DEWITT PRO-5 5 OZ. WOVEN WEED BARRIER OR SIMILAR TO BE INSTALLED UNDER ALL ROCK MULCH IN PLANTER AREAS.				

TABLE 11-33-2-E: VEGETATION CREDIT TABLE		
TYPE OF PLANT MATERIAL	CREDIT IN SF.	TOTAL IN SF.
EVERGREEN TREE (AT LEAST 25 FT. TALL AT MATURITY)	100	800
SHADE TREE	50	150
ORNAMENTAL TREE	25	125
LARGE SHRUB (MORE THAN 8' TALL AT MATURITY)	50	-
MEDUIM SHRUB (4-8' TALL AT MATURITY)	25	475
SMALL SHRUB (LESS THAN 4' TALL AT MATURITY)	10	200
COLUMNAR DECIDUOUS OR EVERGREEN TREE	25	-
COLUMNAR EVERGREEN SHRUB (LESS THAN 8' TALL AT MATURITY)	10	-
EVERGREEN GROUND COVER	25	1675
PERENNIAL PLANT AND GROUND COVER, BULB/TUBER AND ORNAMENTAL GRASS	5	555
1. DWARF TREES OR TREE VARIETIES WITH A MATURE WIDTH OF LESS THAN 10'	25	-
2. LARGE ORNAMENTAL GRASS, OVER 4' TALL AT MATURITY	10	50

0 20 40 60 feet

SCALE: 1" = 20' ON A 24 X 36 SHEET

DRAWINGS, SPECIFICATIONS AND OTHER DOCUMENTS, PREPARED BY LANDARC, LLC AND LANDARC LLC'S CONSULTANTS ARE INSTRUMENTS OF SERVICE FOR USE SOLELY WITH RESPECT TO THIS PROJECT. THIS INCLUDES DOCUMENTS IN ELECTRONIC FORM. LANDARC, LLC AND ITS CONSULTANTS SHALL BE DEEMED THE AUTHORS AND OWNERS OF THEIR RESPECTIVE INSTRUMENTS OF SERVICE AND SHALL RETAIN ALL COMMON LAW, STATUTORY AND OTHER RESERVED RIGHTS, INCLUDING COPYRIGHTS. THE INSTRUMENTS OF SERVICE SHALL NOT BE USED BY THE OWNER FOR FUTURE ADDITIONS OR ALTERATIONS TO THIS PROJECT OR FOR OTHER PROJECTS, WITHOUT THE PRIOR WRITTEN AGREEMENT OF LANDARC, LLC. ANY UNAUTHORIZED USE OF THE INSTRUMENTS OF SERVICE SHALL BE AT THE OWNER'S SOLE RISK AND WITHOUT LIABILITY TO LANDARC, LLC AND LANDARC LLC'S CONSULTANTS. © 2026 LANDARC, LLC.

LANDARC
P.O. BOX 92
125 E. 100 N.
HEBER CITY, UT 84032
utlandarc@gmail.com
435.654.4414

SEAL

REGISTERED LANDSCAPE ARCHITECT
CERTIFICATE NO.
77607
ZACHARY TAYLOR
STATE OF UTAH
ASSOCIATE

PROJECT

CANNON BEACH HOTEL
MESA, AZ

ISSUE DRAWING LOG

CALL 811 BEFORE YOU DIG
811
SAFE DIGGING PARTNER

TITLE

LANDSCAPE PLAN

NUMBER

L100

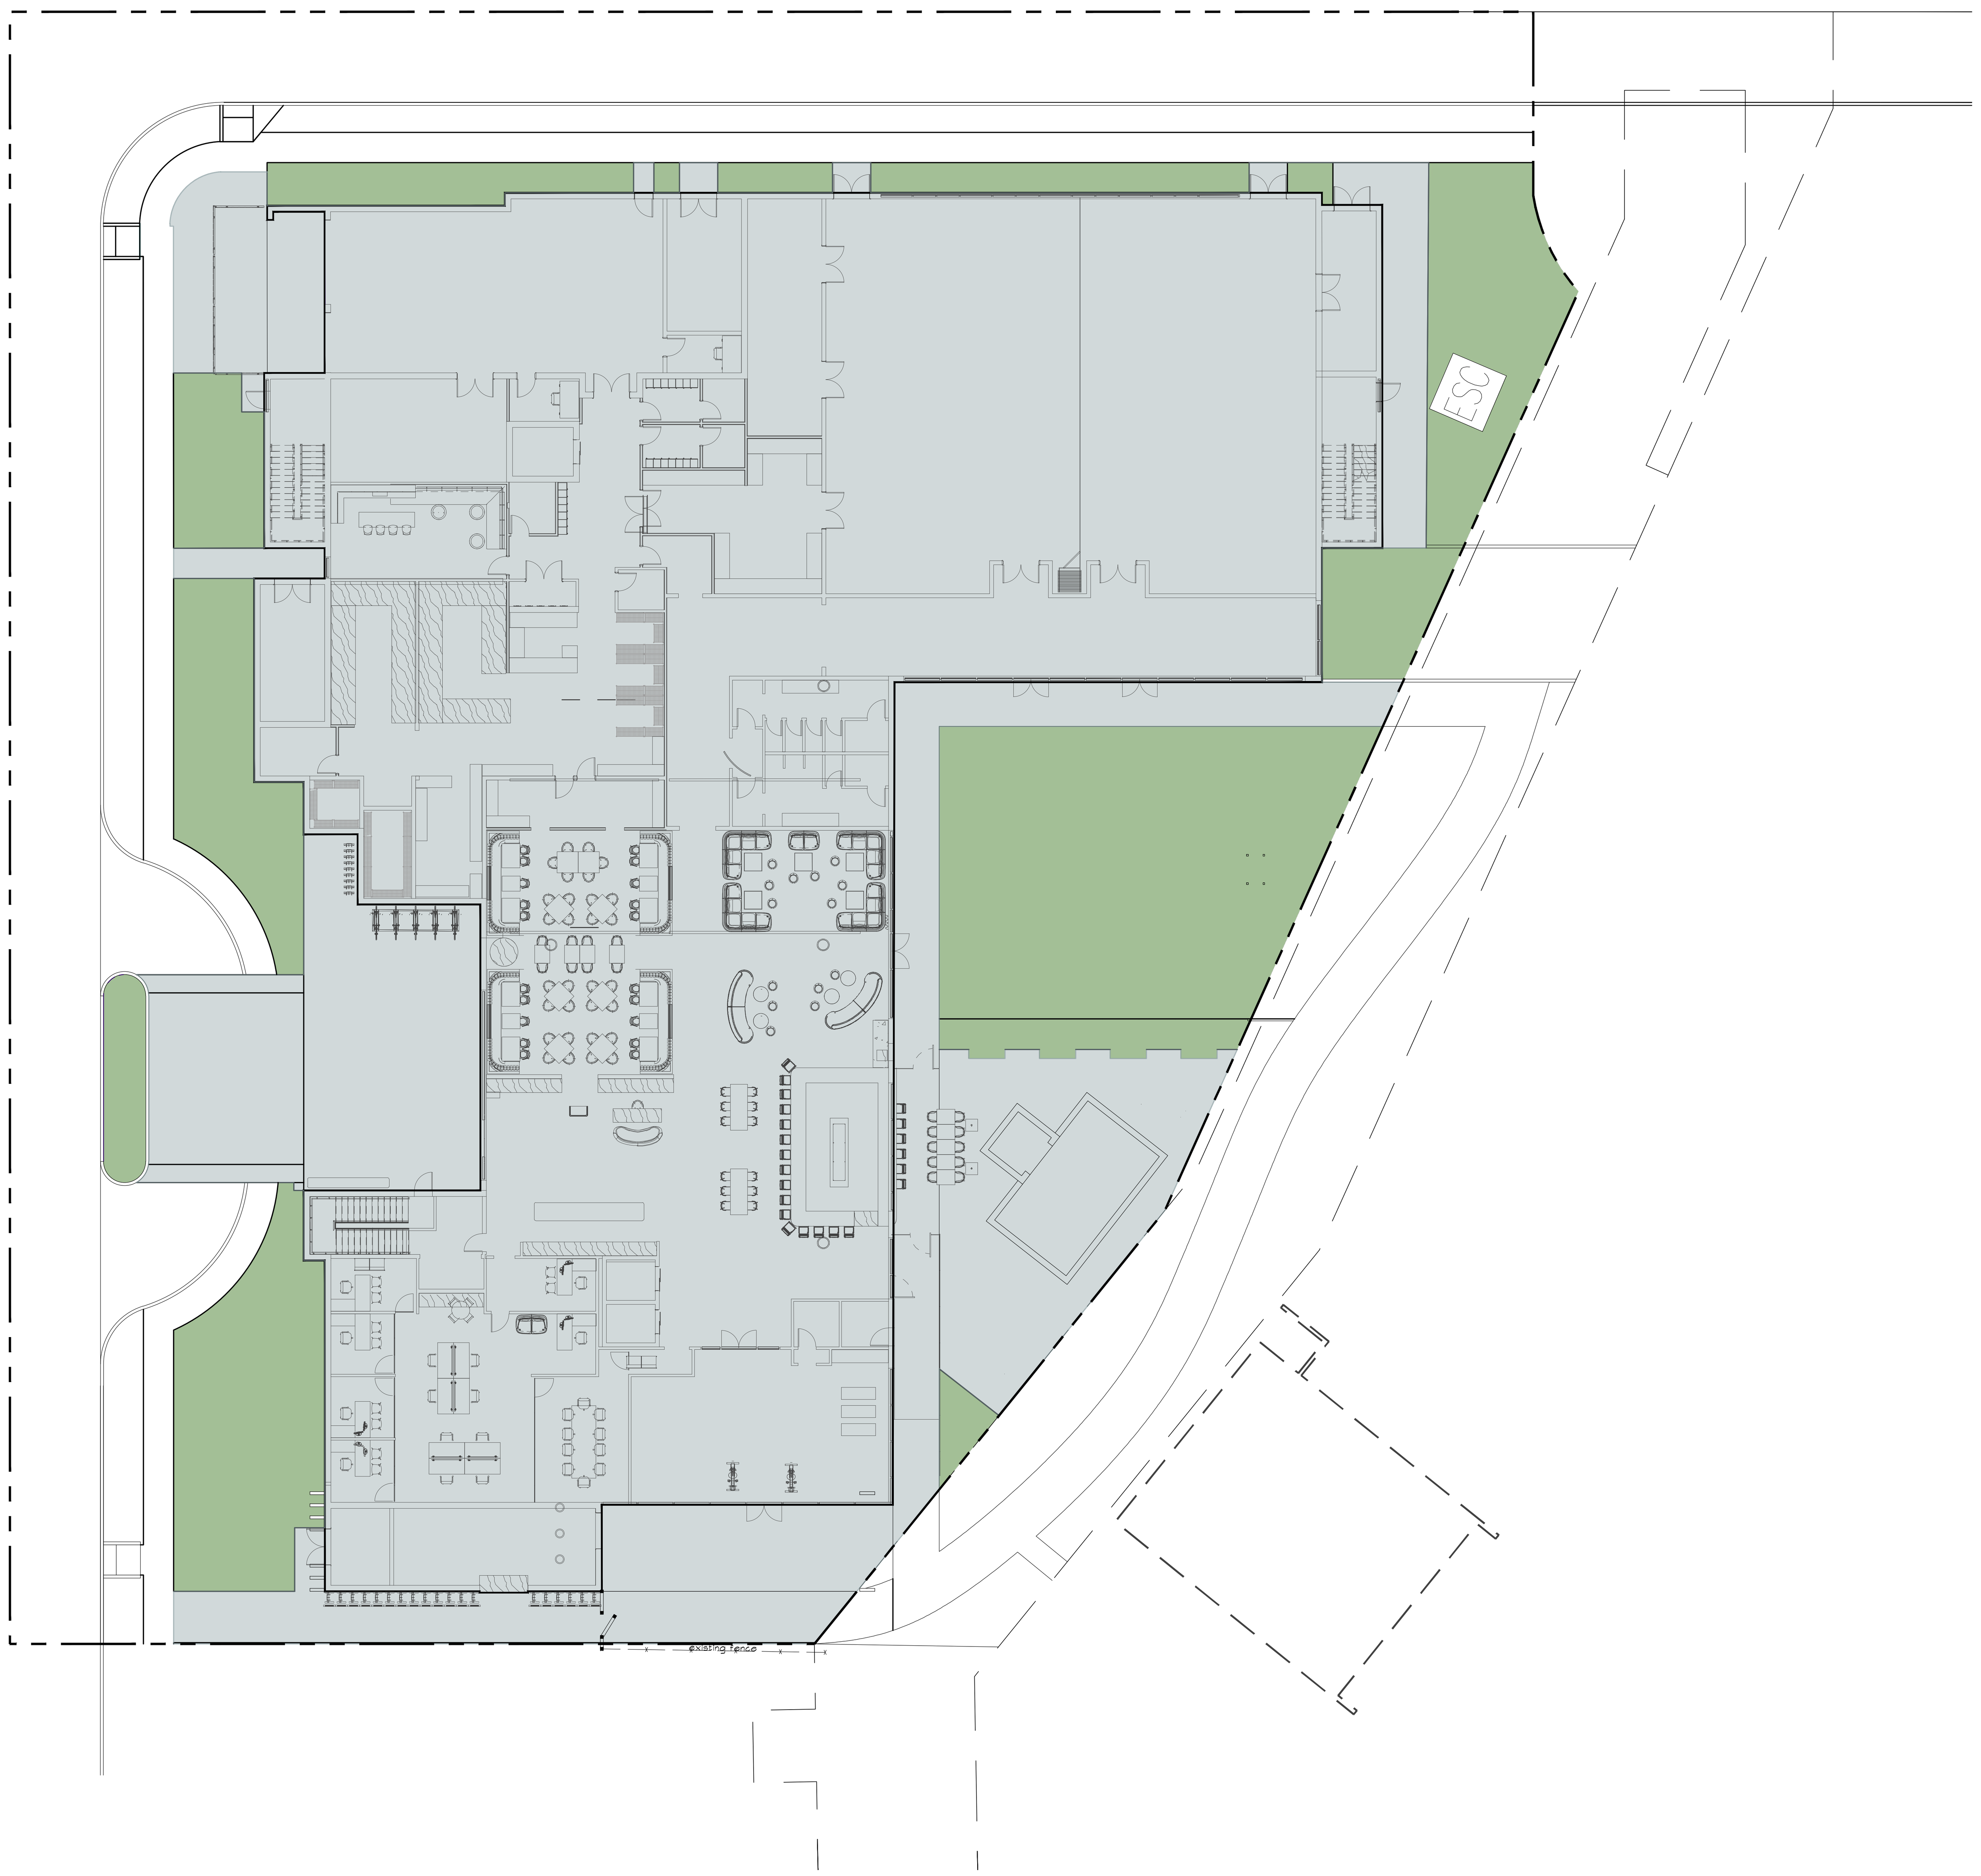

CALCULATED IMPERVIOUS AREA

CALCULATED LANDSCAPE AREA

IMPERVIOUS AREA TABULATIONS		
TOTAL SITE AREA	57,647 SF.	100%
TOTAL IMPERVIOUS AREA FROM BACK OF WALK	35,917 SF.	62.3%
TOTAL LANDSCAPE AREA FROM BACK OF WALK	8,469 SF.	14.7%

0 20 40 60 feet

SCALE: 1" = 20' ON A 24 X 36 SHEET

LANDARC
P.O. BOX 92
125 E. 100 N.
HEBER CITY, UT 84032
utlandarc@gmail.com
435.669.4414

SEAL

REGISTERED LANDSCAPE ARCHITECT
CERTIFICATE NO.
77607
ZACHARY
TAYLOR
DATE SIGNED 3/12/2026
ARIZONA U.S.A.

PROJECT

CANNON BEACH HOTEL

MESA, AZ

ISSUE DRAWING LOG

CALL 811 BEFORE YOU DIG
811
SAFE DIGGING PARTNER

TITLE

IMPERVIOUS LOT COVERAGE

NUMBER

L102

DRAWINGS, SPECIFICATIONS AND OTHER DOCUMENTS, PREPARED BY LANDARC, LLC AND LANDARC LLC'S CONSULTANTS ARE INSTRUMENTS OF SERVICE FOR USE SOLELY WITH RESPECT TO THIS PROJECT. THIS INCLUDES DOCUMENTS IN ELECTRONIC FORM. LANDARC, LLC AND ITS CONSULTANTS SHALL BE DEEMED THE AUTHORS AND OWNERS OF THEIR RESPECTIVE INSTRUMENTS OF SERVICE AND SHALL RETAIN ALL COMMON LAW, STATUTORY AND OTHER RESERVED RIGHTS, INCLUDING COPYRIGHTS. THE INSTRUMENTS OF SERVICE SHALL NOT BE USED BY THE OWNER FOR FUTURE ADDITIONS OR ALTERATIONS TO THIS PROJECT OR FOR OTHER PROJECTS, WITHOUT THE PRIOR WRITTEN AGREEMENT OF LANDARC, LLC. ANY UNAUTHORIZED USE OF THE INSTRUMENTS OF SERVICE SHALL BE AT THE OWNER'S SOLE RISK AND WITHOUT LIABILITY TO LANDARC, LLC AND LANDARC LLC'S CONSULTANTS. © 2026 LANDARC, LLC.

NOTES:

1. INSTALL TREE PLUMB
2. FOR ALL FALL PLANTING, WRAP TRUNK TO LOWEST BRANCH. REMOVE THE FOLLOWING SPRING.

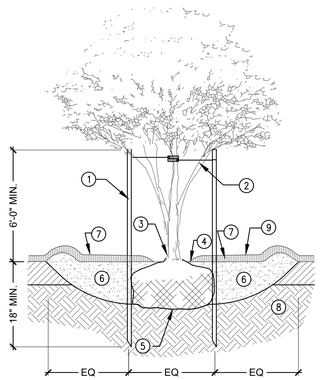

1. 2" DIA. (ROUND) FIR POSTS; 2 PER TREE. ALL POSTS SHALL BE PLUMB AND HAVE SAME HEIGHT ABOVE FINISH GRADE.
2. GALVANIZED WIRE CABLE LOOPED THROUGH 1" GROMMETED NYLON WEBBING AROUND TRUNK; SECURE BY TWISTING UNTIL TAUT.
3. TOP OF ROOTBALL SHALL BE 1"-2" ABOVE FINISHED GRADE
4. ROOT FLARE SHALL BE EXPOSED; MULCH SHOULD NOT BE WITHIN 4" OF TREE TRUNK
5. PLACE BALL ON UNDISTURBED SUBSOIL. CUT WIRE BASKET AND REMOVE AND DISCARD BURLAP OR OTHER SOD WRAPPING MATERIALS FOR TOP 1/3 OF ROOTBALL
6. EXCAVATE HOLE TO DIAMETER 3X WIDER THAN ROOTBALL. BACKFILL WITH PLANTING SOIL MIX
7. GROUNDCOVER AS SHOWN IN LANDSCAPE PLAN
8. UNDISTURBED SUBGRADE
9. 5' DIA. DEPRESSED WATERING BASIN TO BE FREE FROM ROCK AND DEBRIS

1 DECIDUOUS TREE WITH STAKING

NTS

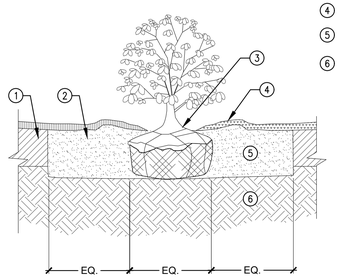

1. PLANTING SOIL MIX
2. GROUNDCOVER AS SHOWN IN LANDSCAPE PLAN
3. SET ROOT FLARE 2" HIGHER THAN FINISH GRADE TO ALLOW FOR SETTLING
4. BERM TO FORM DEPRESSED WATERING BASIN
5. PLANTING SOIL MIX
6. UNDISTURBED SUBGRADE

NOTES:

1. PLACE BALL ON UNDISTURBED SUBGRADE. REMOVE AND DISCARD WRAPPING MATERIAL EXCEPT UNDER BALL.
2. SETTLE PLANT BY FILLING PLANTING PIT WITH WATER USING HOSE OR BUCKET.
3. MULCH SHOULD NOT BE WITHIN 4" OF TRUNK.
4. REMOVE WATERING BASIN PRIOR TO END OF MAINTAINANCE PERIOD.

2 SHRUB

NTS

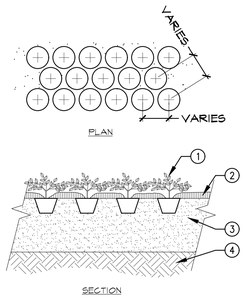

1. GROUNDCOVER/PERENNIALS (SEE NOTE)
2. 3-4" MIN. BARK MULCH OR GRAVEL, PER PLAN
3. PLANTING SOIL MIX
4. UNDISTURBED SUBGRADE

NOTE:
1. SEE PLANTING LEGEND FOR SPACING

3 GROUNDCOVER / PERENNIAL

NTS

PLANTING NOTES

1. THE BASE INFORMATION FOR THIS DRAWING WAS OBTAINED FROM OTHERS. THE CONTRACTOR IS RESPONSIBLE FOR VERIFYING THE DRAWING WITH ACTUAL FIELD CONDITIONS PRIOR TO BEGINNING ANY WORK, AND IMMEDIATELY NOTIFYING THE LANDSCAPE ARCHITECT OF ANY DISCREPANCIES. IN THE EVENT THAT THE CONTRACTOR BEGINS WORK PRIOR TO VERIFYING AND COMPARING THE BASE INFORMATION WITH ACTUAL FIELD CONDITIONS, THEN ANY CHANGES OR ALTERATIONS TO THE WORK INVOLVED WITH THESE DRAWINGS DUE TO SUCH DISCREPANCIES WILL BE PERFORMED BY THE CONTRACTOR AT NO ADDITIONAL EXPENSE TO THE OWNER.

2. THE CONTRACTOR IS RESPONSIBLE FOR VERIFYING AND MARKING THE LOCATIONS OF ALL UTILITIES WITHIN THE LIMITS OF WORK PRIOR TO BEGINNING CONSTRUCTION. CONTACT THE OWNER, BLUE STAKES OF UTAH (1-800-662-4111), AND ALL OTHER ENTITIES AS NECESSARY. IN THE EVENT THAT THE CONTRACTOR BEGINS WORK PRIOR TO VERIFYING AND STAKING ALL UTILITIES, AND DAMAGE TO UTILITIES OCCURS, THE DAMAGED UTILITIES WILL BE PREPARED AND/OR REPLACED AT NO ADDITIONAL COST TO THE OWNER.

3. IF PROVIDED, REFER TO LEGENDS, NOTES, DETAILS, AND SPECIFICATIONS FOR FURTHER INFORMATION.

4. ANY ALTERATIONS TO THESE ACTUAL PLANTING PLANS DURING CONSTRUCTION SHALL BE REPORTED TO THE LANDSCAPE ARCHITECT AND RECORDED ON 'AS BUILT' DRAWINGS.

5. ALL PLANT MATERIAL SHALL CONFORM TO THE MINIMUM GUIDELINES ESTABLISHED BY THE AMERICAN STANDARD FOR NURSERY STOCK, PUBLISHED BY THE AMERICAN NURSERY ASSOCIATION, INC.

6. ALL PLANTS TO BE BOX, OR CONTAINER GROWN, UNLESS OTHERWISE NOTED ON THE PLANT LIST.

7. QUANTITIES INDICATED IN THE PLANT SCHEDULE ARE FOR CONVENIENCE ONLY. THE CONTRACTOR IS RESPONSIBLE FOR VERIFYING ALL QUANTITIES, AND SHALL SUPPLY ALL PLANT MATERIAL IN QUANTITIES SUFFICIENT TO COMPLETE THE PLANTING DESIGN SHOWN ON THE PLANS, REGARDLESS OF QUANTITIES INDICATED IN THE PLANT SCHEDULE.

8. ANY PROPOSED SUBSTITUTIONS OF PLANT SPECIES SHALL BE MADE WITH PLANTS OF EQUIVALENT OVERALL FORM, HEIGHT, BRANCHING HABIT, FLOWER, LEAF, COLOR, FRUIT AND CULTURE ONLY AS APPROVED BY THE LANDSCAPE ARCHITECT PRIOR TO INSTALLATION.

9. ALL PLANTER BEDS SHALL RECEIVE 4" OF TOPSOIL MIN. BACKFILL ALL PLANTING PITS WITH TOPSOIL.

11. PRUNE ANY TREES NEXT TO SIDEWALKS TO A MINIMUM HEIGHT OF 7' FOR A CLEAR WALKING PATH.

DRAWINGS, SPECIFICATIONS AND OTHER DOCUMENTS, PREPARED BY LANDARC, LLC AND LANDARC LLC'S CONSULTANTS ARE INSTRUMENTS OF SERVICE FOR USE SOLELY WITH RESPECT TO THIS PROJECT. THIS INCLUDES DOCUMENTS IN ELECTRONIC FORM. LANDARC, LLC AND ITS CONSULTANTS SHALL BE DEEMED THE AUTHORS AND OWNERS OF THEIR RESPECTIVE INSTRUMENTS OF SERVICE AND SHALL RETAIN ALL COMMON LAW, STATUTORY AND OTHER RESERVED RIGHTS, INCLUDING COPYRIGHTS. THE INSTRUMENTS OF SERVICE SHALL NOT BE USED BY THE OWNER FOR FUTURE ADDITIONS OR ALTERATIONS TO THIS PROJECT OR FOR OTHER PROJECTS, WITHOUT THE PRIOR WRITTEN AGREEMENT OF LANDARC, LLC. ANY UNAUTHORIZED USE OF THE INSTRUMENTS OF SERVICE SHALL BE AT THE OWNER'S SOLE RISK AND WITHOUT LIABILITY TO LANDARC, LLC AND LANDARC LLC'S CONSULTANTS. © 2026 LANDARC, LLC.

LANDARC
P.O. BOX 92
125 E. 100 N
HEBER CITY, UT 84032
utlandarc@gmail.com
435.664.4414

SEAL

REGISTERED LANDSCAPE ARCHITECT
CERTIFICATE NO.
77607
ZACHARY TAYLOR
STATE OF UTAH
ASLA MEMBER

PROJECT

CANNON BEACH HOTEL
MESA, AZ

ISSUE DRAWING LOG

CALL 811 BEFORE YOU DIG
811
SAFE DIGGING PARTNER

TITLE

DETAILS & NOTES

NUMBER

L101